

Pearl R.
P-13
8-14-63

WATER WELL DRILLERS LOG

CODED

Date: AUG 14, 1963, Driller: POUPARTPEARL
County RIVER495-3
(Name)

(1) Owner of Land:	Description & Color of Materials Sand, Clay, Red Clay, Shell, etc.	Thick- ness Feet	Depth Feet
GREYSON SPIERS (Name) MILL CREEK (Address)	Soil	20	
(2) Location: <u>1/4, 1/4, Sec. 28 T17 R17</u> <u>6</u> miles <u>WEST</u> , of <u>N. Neill</u> (distance) (direction) (Nearest Town)	SAND		
	GRAVEL	40	60
	BLUE CLAY	120	180
	GREY SAND ORSE		
(3) Topography: <u>✓</u> (Hilly) (Flat) (Level)		36	216
(4) Purpose of Well: <u>DOMESTIC</u> (Domestic Irrigation Municipal, Industrial, Other)			


Information upon completion of well:

- (1) Diameter 2 inches.
- (2) Total Depth 216 feet.
- (3) Water Level 70 feet below top of ground.
- (4) Cased to _____, Size _____.
- (5) Screen: Size 010, Length 5'.
- (6) Were any formations sealed against pollution?
_____ yes, _____ no.

If YES depth of formation _____

Why _____

Drillers Remarks: _____

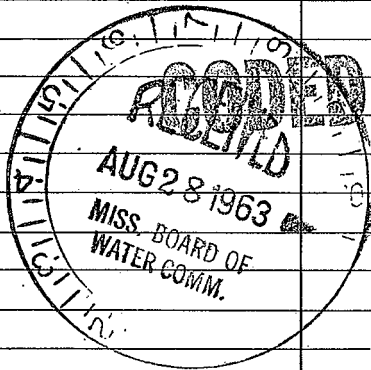

(Use Back Side)

Well No.

Mail this copy to Board of Water Commissioners 429 Miss. St. Jackson, Miss

