

WATER WELL DRILLERS LOG

CODED

Pearl River
Date: Sept 14 1963 Driller: POUPART County: PEARL RIVER
P-14 (Name)

9-12-63
(1) Owner of Land: CHARLES SPIERS
(Name)
MILL CREEK
(Address)
(2) Location: 1/4, 1/4, Sec. 28 T4 R2,
6 miles West, of McNeill
(distance) (direction) (Nearest Town)
(3) Topography: ✓
(Hilly) (Flat) (Level)
(4) Purpose of Well: DOMESTIC
(Domestic Irrigation
Municipal, Industrial, Other)


Description & Color of Materials Sand, Clay, Red Clay, Shell, etc.	Thick- ness Feet	Depth Feet
<u>Red SAND + CLAY</u>	<u>25</u>	
<u>-Blue Clay</u>	<u>155</u>	<u>180</u>
<u>Grey SAND</u>	<u>30</u>	<u>210</u>

Information upon completion of well:

- (1) Diameter 2 inches.
- (2) Total Depth 210 feet.
- (3) Water Level 65 feet below top of ground.
- (4) Cased to _____, Size _____
- (5) Screen: Size 010, Length 5
- (6) Were any formations sealed against pollution?
_____ yes, _____ no.

CODED

If YES depth of formation _____
Why _____
Drillers Remarks: _____

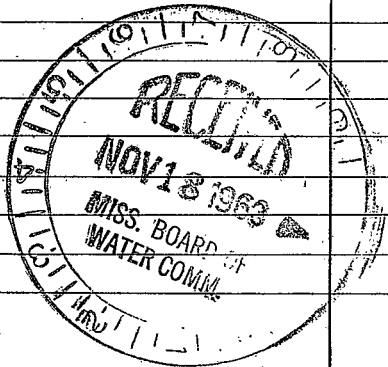

(Use Back Side)

Well No.

