

Pearl R.
OP-15
7-6-65

MISSISSIPPI BOARD OF WATER COMMISSIONERS

WATER WELL DRILLERS LOG

CODED

Date: 7-6, 1965, Driller: Walter Pearlton County Pearl River

(Name)

(1) Owner of Land: Oliver Kennedy

(Name)

Rt. 1 Carriere, Miss

(Address)

(2) Location: 1/4, 1/4, Sec. 33 T45R17

5 miles N.W. of Carriere

(distance)

(direction)

(Nearest Town)

(3) Topography: Hilly

(Hilly)

(Flat)

(Level)

(4) Purpose of Well: Domestic

(Domestic Irrigation
Municipal, Industrial, Other)

Description & Color of Materials
Sand, Clay, Red Clay, Shell, etc.

Thick-
ness
Feet

Depth
Feet

Red clay	14	0 to 4
Red & yellow sand	34	48
yellow clay	6	54
Blue clay	122	176
Brown sand	65	241
Grey sand		258

Information upon completion of well:

(1) Diameter 2 inches.

(2) Total Depth 258 feet.

(3) Water Level 67 feet below top of ground.

(4) Cased to _____, Size _____

(5) Screen: Size 10, Length 5 ft.

(6) Were any formations sealed against pollution?


_____ yes, _____ no.

If YES depth of formation _____

Why _____

Drillers Remarks: _____

CODED

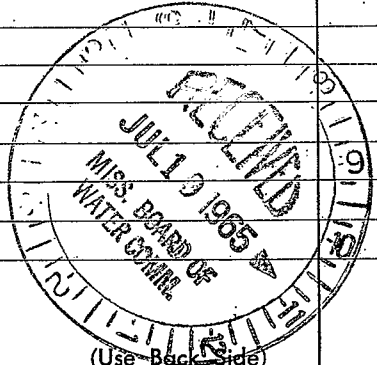

(Use Back Side)

Well No.

