

P-18
5-17-66

WATER WELL DRILLERS LOG

CODED

Date: 5-27, 1966, Driller: NEIL LUMPKIN County PEARL RIVER
5-17-66 (Name)

(1) Owner of Land:	Description & Color of Materials Sand, Clay, Red Clay, Shell, etc.	Thick- ness Feet	Depth Feet
<u>Boyce Cooper</u> (Name) <u>McNeill, Miss.</u> (Address)	<u>Surface clay</u>	<u>0</u>	<u>15</u>
(2) Location: <u>1/4</u> , <u>1/4</u> , Sec. <u>25 T4 R17</u> , <u>2</u> miles <u>west</u> of <u>McNeill</u> , (distance) (direction) (Nearest Town)	<u>Good sand</u>	<u>15</u>	<u>60</u>
(3) Topography: <u>Hilly</u> (Hilly) (Flat) (Level)			
(4) Purpose of Well: <u>Domestic</u> (Domestic Irrigation Municipal, Industrial, Other)			

Information upon completion of well:

(1) Diameter 2 inches.

(2) Total Depth 60 feet.

(3) Water Level 30 feet below top of ground.

(4) Cased to _____, Size _____.

(5) Screen: Size 2, Length 5'.


(6) Were there any formations sealed against pollution?
_____ yes, no.

If YES depth of formation _____

Why _____

Drillers Remarks: _____

CODED

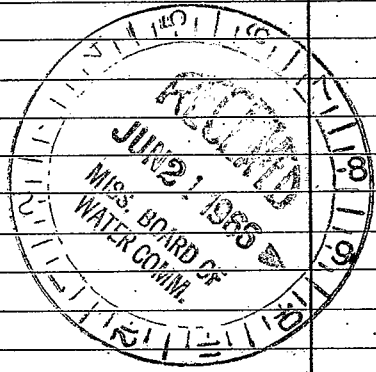

(Use Back Side)

Well No.

