

P-19

WATER WELL DRILLERS LOG

2-28-68
 Date: Feb 28, 1968, Driller: POUPART
 (Name)

PEARL RIVER
CODED

(1) Owner of Land: <u>Dwight Henley</u> (Name)	Description & Color of Materials Sand, Clay, Red Clay, Shell, etc.	Thick- ness Feet	Depth Feet
<u>RT 1 CARRIERE</u> (Address)	<u>Red Clay</u>	<u>20</u>	<u>10</u>
(2) Location: <u>1/4, 1/4, Sec. 11 T4R17</u>	<u>Blue "</u>	<u>10</u>	<u>30</u>
<u>6</u> miles <u>West</u> , of <u>McNeill</u> (distance) (direction) (Nearest Town)	<u>Yellow SAND</u>	<u>30</u>	<u>60</u>
(3) Topography: <input checked="" type="checkbox"/> (Hilly) <input type="checkbox"/> (Flat) <input type="checkbox"/> (Level)	<u>Blue Clay</u>	<u>60</u>	<u>120</u>
(4) Purpose of Well: <u>Domestic</u> (Domestic Irrigation Municipal, Industrial, Other)	<u>Clay + SAND</u>	<u>60</u>	<u>180</u>
	<u>Course SAND.</u>	<u>15</u>	<u>195</u>


Information upon completion of well:

- (1) Diameter: 2 inches.
- (2) Total Depth: 195 feet.
- (3) Water Level: 60 feet below top of ground.
- (4) Cased to _____, Size _____
- (5) Screen: Size 012, Length 5
- (6) Were any formations sealed against pollution?
 _____ yes, _____ no.

If YES depth of formation _____
 Why _____

Drillers Remarks: _____

CODED

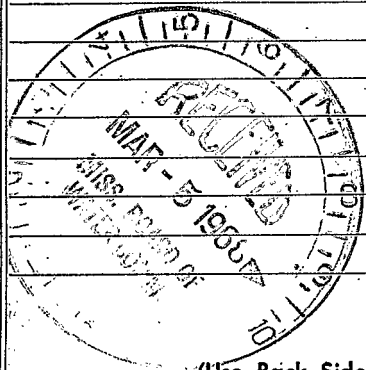

(Use Back Side)

Well No.

