

Pearl River

P 20

9-13-71

MISSISSIPPI
 BOARD OF WATER COMMISSIONERS
 416 North State Street
 Jackson, Mississippi 39201

CODED

WATER WELL DRILLERS LOG

9-13 1971 Earl Pentad water well serv. Pearl River
 date well completed firm name county well located

LANDOWNER:

J.O. Creaslonnie
 McNeil Miss.
 (mailing address)

description of formations encountered

from to

Red clay 0 30

white clay 30 52

Fine white sd. 52 64

Red clay 64 70

Coarse white sd.
cravel 70 80

WELL LOCATION:

sec 26 T 4 N R 17 E
 2 1/2 miles West of McNeil
 (distance) (direction) (nearest town)

WELL PURPOSE: Home
(home, irrigation, municipal, industrial)

WELL COMPLETION DATA:

- (1) diameter (inches) 4 3/4
- (2) total depth (feet) 170'
- (3) static water level (feet) 84' below top of ground.
- (4) casing Galv. 165' (material) (depth)
2" (size) If telescope see back.
- (5) screen 5' 165' (length) (depth to top)
2" (size) 5.5. (material)
- (6) pump 1 (HP) 420 P.H. (yield gpm)
Elect. (type power)
- (7) electric log NO (yes or no)
- (8) how well bottom plugged shoe

white clay 80 102
 Blue clay 102 126
 Fine Blue sd. 126 160
 medium 160 170

CODED


NOV 29 1971

MISS. BD. OF
WATER COMM

DRILLERS REMARKS:

If well telescopes please sketch and show depths.

GROUND LEVEL

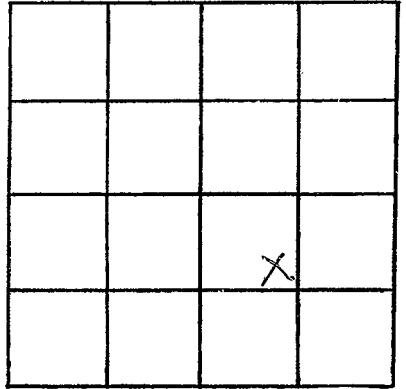

SECTION 26

Please indicate well location X.

ADDITIONAL INFORMATION

If more than one screen,
show locations of each on sketch.