

PEARL RIVER
PZZ
1-17-72

MISSISSIPPI
 BOARD OF WATER COMMISSIONERS
 416 North State Street
 Jackson, Mississippi 39201

CODED

WATER WELL DRILLERS LOG

Water Well Above
 Pearl River

Jan 17 1972 *Essley Stafford* firm name Pearl River county well located
 date well completed

LANDOWNER: *S. Bezone*
Rt 1, Box 227
Carriere Miss
 (mailing address)

WELL LOCATION:
 sec. *19* T. *4* N. R. *17* E.
 S. W.
1 miles *N* with *Hickfield*
 (distance) (direction) (nearest town)

WELL PURPOSE:
 (home, irrigation, municipal, industrial)

- WELL COMPLETION DATA:
- (1) diameter (inches) 4
 - (2) total depth (feet) 89
 - (3) static water level (feet) 50 below above top of ground.
 - (4) casing Plastic, 79
 (material) (depth)
4 in if telescope see back.
 (size)
 - (5) screen 10 ft, 79 ft
 (length) (depth to top)
4 in, Plastic
 (size) (material)
 - (6) pump 1/2 10
 (HP) (yield gpm)
Electric
 (type power)
 - (7) electric log
 (yes or no)

 (organization running log)
 - (8) how well bottom plugged B.W.V.

description of formations encountered	from	to
Top Soil & Red Clay	0	3.5
Chalk	3.5	50
Sand & Gravel	50	89

CODED


JAN 20 1972

MISS. Bd. of
 WATER COMMISSIONERS

DRILLERS REMARKS:
Clear Duncan

If well telescopes please sketch and show depths.

GROUND LEVEL

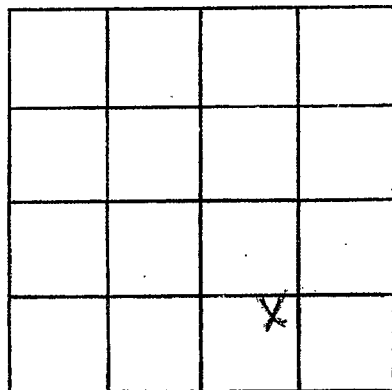

SECTION _____

Please indicate well location X.

ADDITIONAL INFORMATION

If more than one screen, show locations of each on sketch.