

PEARL RIVER
P23
3-29-72

MISSISSIPPI
 BOARD OF WATER COMMISSIONERS
 416 North State Street
 Jackson, Mississippi 39201

WATER WELL DRILLERS LOG

CODED

3-29 1972 Penitow Well Serv Pearl River
 date well completed firm name county well located

LANDOWNER: <u>Leslie Kirkland</u>	description of formations encountered	from	to
<u>Rt. 1</u>	<u>Surface clay</u>	<u>0</u>	<u>16</u>
<u>Carriere Miss</u> (mailing address)	<u>Sand</u>	<u>16</u>	<u>26</u>
<u>WELL LOCATION:</u>	<u>White clay</u>	<u>26</u>	<u>50</u>
sec. <u>27</u> T <u>4</u> N R <u>17</u> E	<u>Blue clay</u>	<u>50</u>	<u>160</u>
<u>4</u> S <u>W</u>	<u>Sand</u>	<u>160</u>	<u>222</u>
<u>3</u> miles <u>West</u> of <u>McNeil</u>	<u>Blue clay</u>	<u>222</u>	<u>280</u>
(distance) (direction) (nearest town)	<u>Sand</u>	<u>280</u>	<u>425</u>
<u>WELL PURPOSE: Home</u> (home, irrigation, municipal, industrial)	<u>Blue clay</u>	<u>425</u>	<u>640</u>
<u>WELL COMPLETION DATA: 4 1/2</u>	<u>Sand</u>	<u>640</u>	<u>755</u>
(1) diameter (inches) <u>2</u>	<u>Blue clay</u>	<u>755</u>	<u>856</u>
(2) total depth (feet) <u>915</u>	<u>Sand</u>	<u>856</u>	<u>945</u>
(3) static water level (feet) <u>Flow</u> ^{below} top of ground.			
(4) casing <u>Galv.</u> , <u>895</u> (material) (depth)			
<u>2</u> if telescope see back. (size)			
(5) screen <u>20'</u> , <u>895</u> (length) (depth to top)			
<u>2</u> , <u>S. Steel</u> (size) (material)			
(6) pump <u>✓</u> <u>✓</u> (HP) (yield gpm)			
<u>✓</u> (type power)			
(7) electric log <u>NO</u> (yes or no)			
<u> </u> (organization running log)			
(8) how well bottom plugged <u>Bev. Value</u>			
<u>DRILLERS REMARKS: + 8'</u>			


CODED

APR 11 1972

MISSISSIPPI
 BOARD OF WATER COMMISSIONERS
 JACKSON, MISSISSIPPI

If well telescopes please sketch and show depths.

GROUND LEVEL

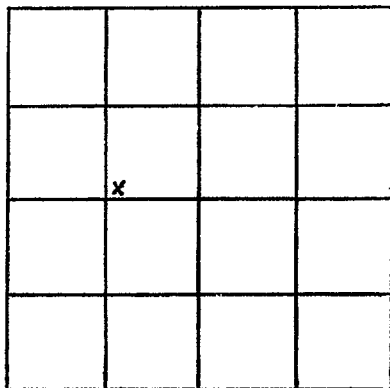

SECTION 27

Please indicate well location X.

ADDITIONAL INFORMATION

If more than one screen,
show locations of each on sketch.