

PEARL RIVER  
P24  
4-19-72

MISSISSIPPI  
 BOARD OF WATER COMMISSIONERS  
 416 North State Street  
 Jackson, Mississippi 39201

**CODED**

WATER WELL DRILLERS LOG

4-19 1972  
 date well completed

Bud Linton & Son  
 firm name

Pearl River  
 county well located

LANDOWNER:

Elliot Bevanon  
Carencro, Miss.  
 (mailing address)

description of formations  
 encountered

from

to

<u>Red Shale</u>	<u>0</u>	<u>12</u>
<u>" Sand</u>	<u>12</u>	<u>26</u>
<u>Black Shale</u>	<u>26</u>	<u>48</u>
<u>Blue Shale</u>	<u>48</u>	<u>200</u>
<u>Sand</u>	<u>200</u>	<u>258</u>

WELL LOCATION:

sec 32 T 4 N R 17 E  
 S W  
3 miles W of Carencro  
 (distance) (direction) (nearest town)

WELL PURPOSE: Home  
 (home, irrigation, municipal, industrial)

WELL COMPLETION DATA:

- (1) diameter (inches) 2 in
- (2) total depth (feet) 258
- (3) static water level (feet) 78 below above top of ground.
- (4) casing Galv, 253  
 (material) (depth)
- (size) if telescope see back.
- (5) screen 5 ft, 253  
 (length) (depth to top)
- 2 x 5, 1/2 Steel 10/12  
 (size) (material)
- (6) pump 1 350  
 (HP) (yield gpm)
- electric  
 (type power)
- (7) electric log NO  
 (yes or no)

**CODED**

(organization running log)

MAY 3 - 1972


(8) how well bottom plugged  
Sand Shale

MISS. DR. OF  
 WATER COMM.

DRILLERS REMARKS:

If well telescopes please sketch and show depths.

GROUND LEVEL

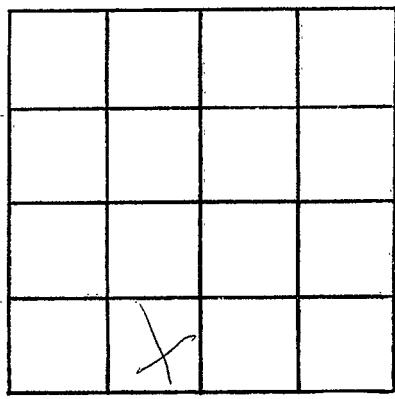

SECTION \_\_\_\_\_

Please indicate well location X.

ADDITIONAL INFORMATION

A series of horizontal lines for writing additional information, starting below the 'ADDITIONAL INFORMATION' header and ending above the bottom-most section line.

If more than one screen, show locations of each on sketch.