

Pearl River  
P27  
4-21-70

MISSISSIPPI  
BOARD OF WATER COMMISSIONERS  
416 North State Street  
Jackson, Mississippi 39201

WATER WELL DRILLERS LOG


4-21-70 date well completed      E.J. Water Well Serv. firm name      Pearl River county well located

LANDOWNER:	description of formations encountered	from	to
WELL LOCATION:			
Wendell Cleon Payne McNeil Miss. (mailing address)	Red clay	0	9
	coarse white sd	9	32
	Blue clay	32	34
	Grey med sd.	34	42
	Yellow clay	42	194
	Coarse sd. & gravel	194	306
WELL LOCATION: S W 253 sec. 12 T 4 R 1 4 miles N-W. of McNeil (distance) (direction) (nearest town)			
WELL PURPOSE: Home (home, irrigation, municipal, industrial)			
WELL COMPLETION DATA:			
(1) diameter (inches) 4.5			
(2) total depth (feet) 306			
(3) static water level (feet) 20' below top of ground			
(4) casing 2" (material) 284 (depth)			
2" if telescope see back.			
(5) screen 20' (length) 284-304 (depth to top)			
2" (size) S.S. (material)			
(6) pump NO (HP) (yield gpm)			
Flowing (type power)			
(7) electric log NO (yes or no)			
(organization running log)			
(8) how well bottom plugged Stone			
DRILLERS REMARKS: Flowing w/ 90' press			

MAY 12 1970  
MISS. BD OF WATER COMM.

If well telescopes please sketch and show depths.

GROUND LEVEL

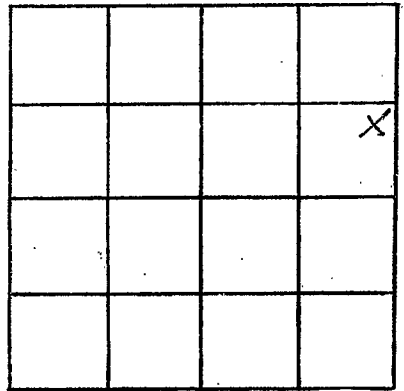

SECTION 12

Please indicate well location X.

ADDITIONAL INFORMATION

If more than one screen, show locations of each on sketch.