

Pearl River
P 28
5-22-70

MISSISSIPPI
 BOARD OF WATER COMMISSIONERS
 416 North State Street
 Jackson, Mississippi 39201

WATER WELL DRILLERS LOG
 NEIL LUMPKIN WELL DRILLING SERVICE
 P. O. BOX 117
 CARRIER, MISS.

Pearl River

5-22 1970
 date well completed

firm name

county well located

LANDOWNER: Argel Barber

description of formations encountered

from

to

P.O. Box 75
Carrier, Miss.
 (mailing address)

Surface Clay 0 15
sand 15 40

WELL LOCATION:

sec. 14 T-4S R-17E 074
2 1/2 miles N of Millbrook
 (distance) (direction) (nearest town)

blue clay, hard 40 80
good grey sand 80 111

WELL PURPOSE: home trailer
 (home, irrigation, municipal, industrial)

WELL COMPLETION DATA:

- (1) diameter (inches) 2"
- (2) total depth (feet) 111'
- (3) static water level (feet) 30 below above top of ground.
- (4) casing galv. (material) (depth)
2" (size) if telescope see back.
- (5) screen 5 (length) (depth to top)
2" (size) St Steel (material)
- (6) pump 1/2 (HP) 450 gph (yield gph)
electric (type power)
- (7) electric log No (yes or no)

(organization running log)

(8) how well bottom plugged Johnson
BP Valve

JUN 1 1970


DRILLERS REMARKS:

MISS. Bd. of
 WATER COMMISSIONERS

incl. 30'
to 3' drop pipe

If well telescopes please sketch and show depths.

GROUND LEVEL

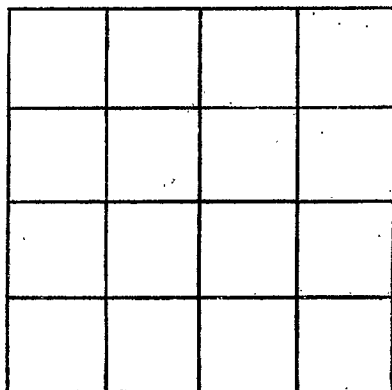

SECTION _____

Please indicate well location X.

ADDITIONAL INFORMATION

If more than one screen, show locations of each on sketch.