

Pearl River
P 29
6-3-70

MISSISSIPPI
 BOARD OF WATER COMMISSIONERS
 416 North State Street
 Jackson, Mississippi 39201

CODED

WATER WELL DRILLERS LOG

6-3 1970 Leaton Well Serv Pearl River
 date well completed firm name county well located

LANDOWNER: William Randle
Rt. 1 Box 303
Enterprise Ala
 (mailing address)

description of formations encountered	from	to
Surface clay	0	20
Sand	20	32
Red clay	32	55
Blue clay	55	160
fine sand	160	218
Blue clay	218	228
grey sand	228	257

WELL LOCATION:
 sec. 33 T 4 R 17
1 1/2 miles South of Mill Creek
 (distance) (direction) (nearest town)

WELL PURPOSE: Home
 (home, irrigation, municipal, industrial)

- WELL COMPLETION DATA:
- (1) diameter (inches) 2
 - (2) total depth (feet) 257
 - (3) static water level (feet) 76 below top of ground.
 - (4) casing Galv, 252,
 (material) (depth)
2" if telescope see back.
 (size)
 - (5) screen 5', 252
 (length) (depth to top)
 - 012 2", S. Steel
 (size) (material)
 - (6) pump 1 7
 (HP) (yield gpm)
Elec
 (type power)
 - (7) electric log NO
 (yes or no)

CODED

(organization running log)

JUN 23 1970


(8) how well bottom plugged B.W. & S.

MISS. BD. OF
 WATER COMM.

DRILLERS REMARKS:

If well telescopes please sketch and show depths.

GROUND LEVEL

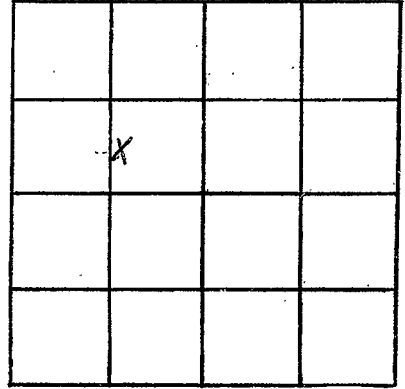

SECTION 33

Please indicate well location X.

ADDITIONAL INFORMATION

If more than one screen,
show locations of each on sketch.