

Pearl River
 P 30
 6-12-70

MISSISSIPPI
 BOARD OF WATER COMMISSIONERS
 416 North State Street
 Jackson, Mississippi 39201

CODED

WATER WELL DRILLERS LOG

6-12
 date well completed

To Neil Lumpkin
 firm name

Pearl River
 county well located

LANDOWNER: Chas. A. Smith

description of formations encountered

from

to

Carriere, Miss.
Route 1
 (mailing address)

Surface Clay 0 20
 ✓ sand 20 65

WELL LOCATION:

sec 24 T 4 R 17
2 miles NW of M^cNeil
 (distance) (direction) (nearest town)

Blue Clay 65 100
good sand 100 132

WELL PURPOSE: home
 (home, irrigation, municipal, industrial)

WELL COMPLETION DATA:

- (1) diameter (inches) 2"
- (2) total depth (feet) 132
- (3) static water level (feet) 50 below above top of ground.
- (4) casing galv. (material) (depth)
2" If telescope see back.
 (size)
- (5) screen 5' (length) (depth to top)
2" St. Steel
 (size) (material)
- (6) pump 1/2 350 gpm.
 (HP) (yield/gpm)
electric
 (type power)
- (7) electric log No.
 (yes or no)

CODED

(organization running log)

(8) how well bottom plugged Johnson
back pressure valve


DRILLERS REMARKS:

JUN 23 1970

MISSISSIPPI
 BOARD OF WATER COMMISSIONERS

If well telescopes please sketch and show depths.

GROUND LEVEL

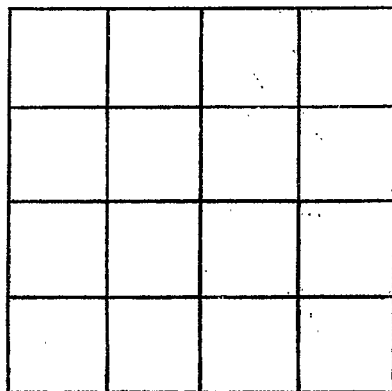

SECTION _____

Please indicate well location X.

ADDITIONAL INFORMATION

If more than one screen, show locations of each on sketch.