

PEARL RIVER
P 32
9-10-70

MISSISSIPPI
BOARD OF WATER COMMISSIONERS
416 North State Street
Jackson, Mississippi 39201

CODED

WATER WELL DRILLERS LOG

9-10 1970 Penton well serv Pearl River
date well completed firm name county well located

LANDOWNER: Earl Roster
Rt. 1 Box -
Picayune Miss
(mailing address)

description of formations encountered	from	to
Surface Clay	0	24
White Clay	24	47
Blue clay	47	132
Sand	132	152

WELL LOCATION:
sec. 31 T. 4 S. R. 17 W.
8 miles North of Picayune
(distance) (direction) (nearest town)

WELL PURPOSE: Home
(home, irrigation, municipal, industrial)

- WELL COMPLETION DATA:
- (1) diameter (inches) 2
 - (2) total depth (feet) 152
 - (3) static water level (feet) 70 below top of ground.
 - (4) casing Galv, 147 (material) (depth)
2 (size) if telescope see back.
 - (5) screen 5', 147 (length) (depth to top)
012 2", 3. Steel (size) (material)
 - (6) pump 1 (HP) (yield gpm)
Elec (type power)
 - (7) electric log No (yes or no)
 - (organization running log)
 - (8) how well bottom plugged B.N. Valco

CODED


OCT 8 1970

DRILLERS REMARKS:

MISS. BD. OF
WATER COMM.

If well telescopes please sketch and show depths.

GROUND LEVEL

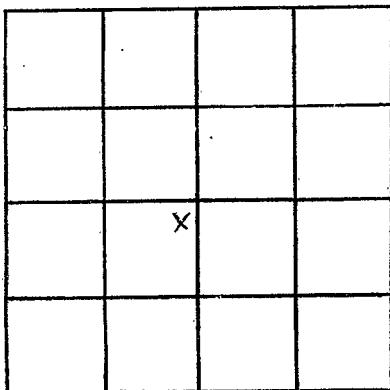

SECTION 31

Please indicate well location X.

ADDITIONAL INFORMATION

If more than one screen,
show locations of each on sketch.