

PEARL RIVER
P35
11-18-70

MISSISSIPPI
BOARD OF WATER COMMISSIONERS
416 North State Street
Jackson, Mississippi 39201

CODED

WATER WELL DRILLERS LOG

NEEL LUMPKIN WELL DRILLING SERVICE

P. O. BOX 117

GARRETTE, MISS.

Pearl River

county well located

11-18 1970
date well completed

LANDOWNER: *Andy Mitchell*
Carriere, Miss.
Route 1
(mailing address)

description of fomations encountered

from to

<i>Surface Clay</i>	<i>0</i>	<i>10</i>
<i>✓ sand</i>	<i>10</i>	<i>38</i>
<i>no good</i>		
<i>Blue Clay</i>	<i>38</i>	<i>80</i>
<i>Good sand</i>	<i>80</i>	<i>111</i>

WELL LOCATION:
sec. *14* T *4* S R. *17* W
8 miles *NW* of *McNeil*
(distance) (direction) (nearest town)

WELL PURPOSE: *home*
(home, irrigation, municipal, industrial)

WELL COMPLETION DATA:

- diameter (inches) *2"*
- total depth (feet) *111"*
- static water level (feet) *40* below top of ground.
- casing *galv.* (material), (depth)
2" (size) if telescope see back.
- screen *5* (length), (depth to top)
2" (size), *5 Steel* (material)
- pump *1/2* (HP), *450 gpm.* (yield gpm)
electric (type power)
- electric log *No.* (yes or no)

CODED

(organization running log)

(8) how well bottom plugged *Johnson*
Back Pressure Valve


DRILLERS REMARKS:

DEC 14 1970

MISS. Bd. OF
WATER COMM.

If well telescopes please sketch and show depths.

GROUND LEVEL

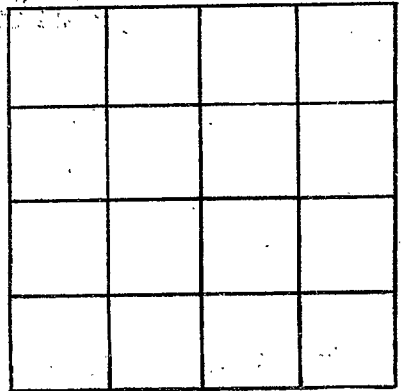

SECTION _____

Please indicate well location X.

ADDITIONAL INFORMATION

If more than one screen,
show locations of each on sketch.