

**PEARL RIVER**  
**P 38**  
**10-6-70**

MISSISSIPPI  
 BOARD OF WATER COMMISSIONERS  
 416 North State Street  
 Jackson, Mississippi 39201

**CODED**

**WATER WELL DRILLERS LOG**

10-6-70 date well completed      1970 Burlington Sewer Well Service firm name      Pearl River county well located

LANDOWNER: Clifford Lee  
Rt 1 h  
Carrriere, Miss  
 (mailing address)

description of formations encountered	from	to
<u>Red Shale</u>	<u>0</u>	<u>38</u>
<u>White Sand &amp; Gravel</u>	<u>38</u>	<u>65</u>

WELL LOCATION:  
 sec 28 T 4 N R 19 E  
4 miles West of McNair  
 (distance) (direction) (nearest town)

WELL PURPOSE: Water  
 (home, irrigation, municipal, industrial)

- WELL COMPLETION DATA:
- (1) diameter (inches) 4 in.
  - (2) total depth (feet) 65
  - (3) static water level (feet) 22 below top of ground.
  - (4) casing plastic, 65  
 (material) (depth)  
 (size) if telescope see back.
  - (5) screen 4x5, 60  
 (length) (depth to top)  
4x5, PVC  
 (size) (material)
  - (6) pump 1/3, 600  
 (HP) (yield gpm)  
Electric  
 (type power)
  - (7) electric log NO  
 (yes or no)  
 (organization running log)
  - (8) how well bottom plugged Back  
Wash Valve

**CODED**

FEB 4 1971


MISS. Bd. of  
 WATER COMMISSIONERS

DRILLERS REMARKS:

If well telescopes please sketch and show depths.

10-0  
10-0  
GROUND LEVEL

Good  
level  
10-0  
10-0

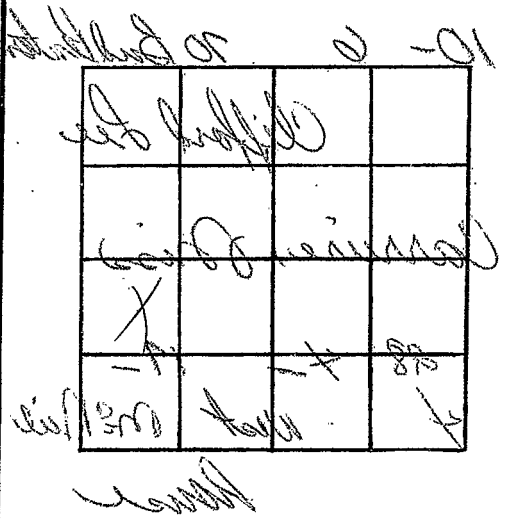

SECTION \_\_\_\_\_

Please indicate well location X.

ADDITIONAL INFORMATION

20  
22  
23  
24  
If more than one screen, show locations of each on sketch.