

PEARL RIVER  
P 40  
1-20-71

MISSISSIPPI  
 BOARD OF WATER COMMISSIONERS  
 416 North State Street  
 Jackson, Mississippi 39201

**CODED**

WATER WELL DRILLERS LOG

NEIL LUMPKIN WELL DRILLING SERVICE  
 P. O. BOX 117  
 CARRIERS, MISS.

Pearl River

1-20- 1971  
 date well completed

CARRIERS, MISS.  
 county well located

LANDOWNER: Frank Meadow

description of formations encountered

from to

Carriere, Miss.  
Route 1  
 (mailing address)

Surface clay 0 10  
sand 10 80

WELL LOCATION:

sec. 28 T 4 S R. 17 W  
7 miles W of M<sup>o</sup> Neill  
 (distance) (direction) (nearest town)

white to blue clay 80 160  
fine to better sand 160 216

WELL PURPOSE: home  
 (home, irrigation, municipal, industrial)

WELL COMPLETION DATA:

- (1) diameter (inches) 2"
- (2) total depth (feet) 216
- (3) static water level (feet) 95 below above top of ground.
- (4) casing galv. (material) (depth)  
2" (size) if telescope see back.
- (5) screen 5' (length) (depth to top)  
2" (size) 5. Steel (material)
- (6) pump 1 (HP) (yield gpm)  
electric (type power)
- (7) electric log No (yes or no)

**CODED**

(organization running log)

(8) how well bottom plugged Johnson Back Pressure Valve


FEB 2 1971

MISS. Bd. of WATER COMM.

DRILLERS REMARKS:

If well telescopes please sketch and show depths.

GROUND LEVEL

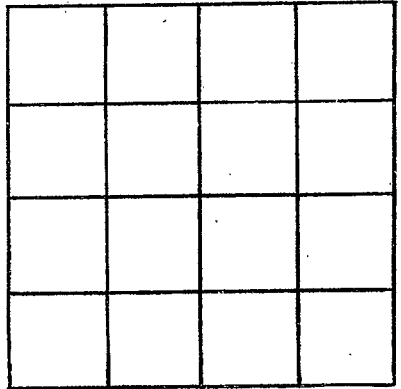

SECTION \_\_\_\_\_

Please indicate well location X.

ADDITIONAL INFORMATION

If more than one screen, show locations of each on sketch.