

PEARL RIVER
 P41
 4-19-72

MISSISSIPPI
 BOARD OF WATER COMMISSIONERS
 416 North State Street
 Jackson, Mississippi 39201

CODED

WATER WELL DRILLERS LOG

4-19-1972 Beed Entwistle Sen Pearl River
 date well completed firm name county well located

LANDOWNER:
Corbet Wayne Spivey
Carrriere, Miss-
 (mailing address)

description of formations encountered	from	to
	<u>Red Shale</u>	<u>0</u>
<u>" Sand</u>	<u>18</u>	<u>36</u>
<u>" Shale</u>	<u>36</u>	<u>46</u>
<u>Sand & Rock</u>	<u>46</u>	<u>63</u>

WELL LOCATION:
 sec 32 T 4 N R 17 E
3 1/2 miles W of Carrriere
 (distance) (direction) (nearest town)

WELL PURPOSE: Home
 (home, irrigation, municipal, industrial)

- WELL COMPLETION DATA:
- (1) diameter (inches) 2 in
 - (2) total depth (feet) 63
 - (3) static water level (feet) 39 below/above top of ground.
 - (4) casing PVC 58
 (material) (depth)
 (size) if telescope see back.
 - (5) screen 3 ft 58
 (length) (depth to top)
2x5 PVC
 (size) (material)
 - (6) pump 1/2 300
 (HP) (yield gpm)
electric
 (type power)
 - (7) electric log No
 (yes or no)

CODED

(organization running log)
 (8) how well bottom plugged Sand Wash


MAY 2 - 1972

DRILLERS REMARKS:

MISS. BD. OF
 WATER COMM.

If well telescopes please sketch and show depths.

GROUND LEVEL

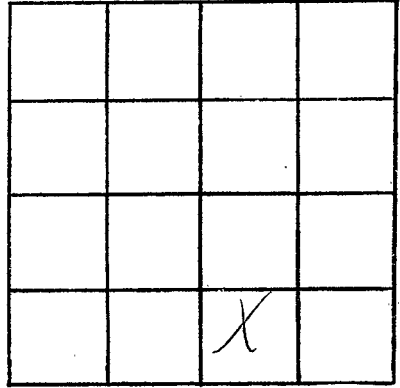

SECTION _____

Please indicate well location X.

ADDITIONAL INFORMATION

If more than one screen, show locations of each on sketch.