

**PEARL RIVER**  
**P42**  
**7-4-72**

MISSISSIPPI  
 BOARD OF WATER COMMISSIONERS  
 416 North State Street  
 Jackson, Mississippi 39201

**CODED**

**WATER WELL DRILLERS LOG**

7-4  
 date well completed

1972  
 firm name

Pearl River  
 county well located

**LANDOWNER:**

William Randle Jr.  
 Carver, Miss.  
 (mailing address)

**description of formations encountered**

	from	to
Red Shales	0	60
White Sand	60	74
White Shale	74	150
Blue Shale	150	205
White Sand	205	246

**WELL LOCATION:**

sec 33 T 4 N R 17 E  
 4 1/2 miles W of Carver  
 (distance) (direction) (nearest town)

**WELL PURPOSE:** Home  
 (home, irrigation, municipal, industrial)

**WELL COMPLETION DATA:**

- (1) diameter (inches) 2 1/2
- (2) total depth (feet) 246
- (3) static water level (feet) 63 below top of ground
- (4) casing Galv 24 (material) (depth)
- (size) if telescope see back.
- (5) screen 2x5 24 (length) (depth to top)
- 2x5 (size) (material)
- (6) pump 1 (HP) 400 (yield gpm)
- electric (type power)
- (7) electric log NO (yes or no)

**CODED**

**(organization running log)**


(8) how well bottom plugged  
 Sand Seal

WELL 104672

**DRILLERS REMARKS:**

If well telescopes please sketch and show depths

GROUND LEVEL

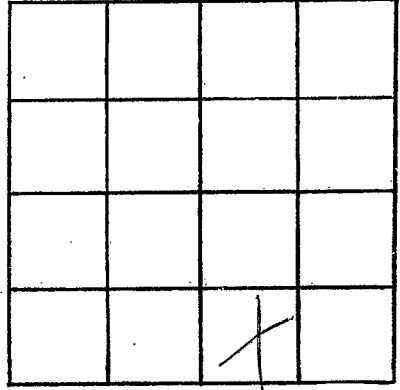

SECTION \_\_\_\_\_

Please indicate well location X.

ADDITIONAL INFORMATION

If more than one screen, show locations of each on sketch.