

PEARL RIVER
P 43
5-15-72

MISSISSIPPI
 BOARD OF WATER COMMISSIONERS
 416 North State Street
 Jackson, Mississippi 39201

CODED

WATER WELL DRILLERS LOG

5-15 1972 Bud Porter & Son Pearl River
 date well completed firm name county well located

LANDOWNER: Samuel Hill
Carriere, Miss.
 (mailing address)

description of formations encountered from to
Red Shale 0 65
Sand & Rock 65 81

WELL LOCATION:
 sec 19 T 4 N R 17 E
7 miles W of Onsley
 (distance) (direction) (nearest town)

WELL PURPOSE: Home
 (home, irrigation, municipal, industrial)

WELL COMPLETION DATA:
 (1) diameter (inches) 2 in.
 (2) total depth (feet) 81 ft.
 (3) static water level (feet) 46 ft. below top of ground.
 (4) casing PVC 77
 (material) (depth)

CODED

(size) if telescope see back.
 (5) screen 2x5 77
 (length) (depth to top)
2x5 PVC
 (size) (material)

(6) pump 1/2 275
 (HP) (yield gpm)
electric
 (type power)

(7) electric log no
 (yes or no)

(organization running log)


(8) how well bottom plugged Sand Shale

THIS IS TO BE
 DEC 10 1972

DRILLERS REMARKS:

If well telescopes please sketch and show depths.

GROUND LEVEL

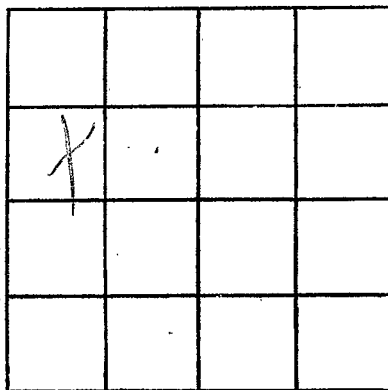

SECTION _____

Please indicate well location X.

ADDITIONAL INFORMATION

If more than one screen, show locations of each on sketch.