

**PEARL RIVER**  
**P 46**  
**7-12-72**

MISSISSIPPI  
 BOARD OF WATER COMMISSIONERS  
 416 North State Street  
 Jackson, Mississippi 39201

**CODED**

**WATER WELL DRILLERS LOG**

7/12 1972 Bud Pentecost & Son Pearl River  
 date well completed firm name county well located

LANDOWNER:  
M.C. Allen Co.  
Chalmers Circle La.  
 (mailing address)

description of formations encountered	from	to
	<u>white shell</u>	<u>0</u>
<u>white sand</u>	<u>14</u>	<u>5 1/2</u>
<u>Blue shell</u>	<u>5-6</u>	<u>20 1/2</u>
<u>Blue sand</u>	<u>20 1/2</u>	<u>54 1/2</u>
<u>Sand Rock</u>	<u>21 1/2</u>	<u>92 1/2</u>

WELL LOCATION:  
 sec 33 T 4 N R 17 E  
4 miles W of Carriere  
 (distance) (direction) (nearest town)

WELL PURPOSE: Home  
 (home, irrigation, municipal, industrial)

WELL COMPLETION DATA:  
 (1) diameter (inches) 9 1/2  
 (2) total depth (feet) 262 ft  
 (3) static water level (feet) 18 below top of ground.  
 (4) casing 900 257  
 (material) (depth)  
 (size) if telescope see back.  
 (5) screen 2 x 5 257  
 (length) (depth-to-top)  
2 0 mm  
 (size) (material)  
 (6) pump \_\_\_\_\_ (HP) \_\_\_\_\_ (yield gpm)  
Electric  
 (type power)  
 (7) electric log no  
 (yes or no)  
 (organization running log)

**CODED**


(8) how well bottom fugged?  
sand sharp

DRILLERS REMARKS:  
no pump furnished

SEP 21 1972

If well telescopes, please sketch and show depths.

GROUND LEVEL

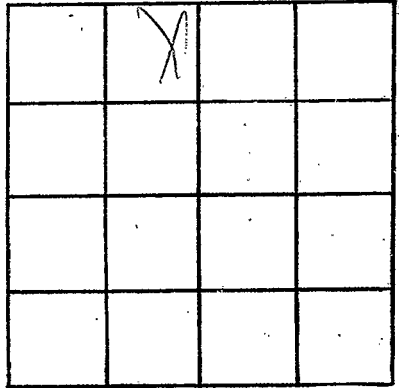

SECTION \_\_\_\_\_

Please indicate well location X.

ADDITIONAL INFORMATION

If more than one screen, show locations of each on sketch.