

PEARL RIVER
P 48
12-72

MISSISSIPPI
 BOARD OF WATER COMMISSIONERS
 416 North State Street
 Jackson, Mississippi 39201

CODED

WATER WELL DRILLERS LOG

1972-19 Bird Kenton & Son Pearl River
 date well completed firm name county well located

LANDOWNER: Wendie Lynne
Jacnell, R. L.
Carrine, Miss.
 (mailing address)

description of formations encountered	from	to
<u>white shale</u>	<u>0</u>	<u>32</u>
<u>blue shale</u>	<u>32</u>	<u>120</u>
<u>fine white sand</u>	<u>120</u>	<u>167</u>
<u>blue shale</u>	<u>132</u>	<u>278</u>
<u>blue sand</u>	<u>278</u>	<u>378</u>
<u>blue shale</u>	<u>378</u>	<u>556</u>
<u>blue sand</u>	<u>556</u>	<u>676</u>

WELL LOCATION:
 sec 27 T 48 N R 12 E
3 miles E of McNair
 (distance) (direction) (nearest town)

WELL PURPOSE: home
 (home, irrigation, municipal, industrial)

WELL COMPLETION DATA:

(1) diameter (inches) 2 in

(2) total depth (feet) 676

(3) static water level (feet) 136 below/above top of ground.

(4) casing 2 in (material), 656 (depth),
2 (size) if telescope see back.

(5) screen 2/20 (length), 656 (depth to top)
2 (size), galv (material)

(6) pump _____ (HP) _____ (yield gpm)
fls (type power)

(7) electric log no (yes or no)

 (organization running log)

CODED


(8) how well bottom plugged slud

DEC 11 1972

DRILLERS REMARKS: work

If well telescopes please sketch and show depths.

GROUND LEVEL

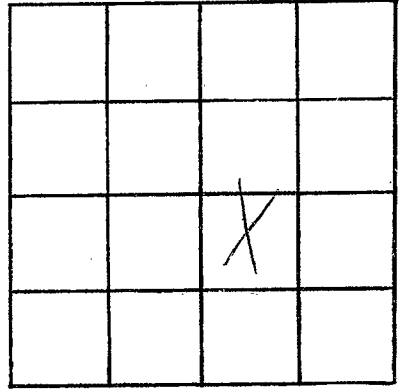

SECTION _____

Please indicate well location X.

ADDITIONAL INFORMATION

If more than one screen, show locations of each on sketch.