

PEARL RIVER
P 49
9-2-72

MISSISSIPPI
 BOARD OF WATER COMMISSIONERS
 416 North State Street
 Jackson, Mississippi 39201

CODED

WATER WELL DRILLERS LOG

9/2 1972 Bud Patton & Son Pearl River
 date well completed firm name county well located

LANDOWNER: Howard Watkins, R. J.
Picayune
 (mailing address)

description of formations encountered	from	to
<u>Yellow shale</u>	<u>0</u>	<u>31</u>
<u>Blue shale</u>	<u>32</u>	<u>245</u>
<u>Blue sand</u>	<u>246</u>	<u>350</u>

WELL LOCATION:
 sec. 13 T. 4 N. R. 17 E.
 (S) (W)
4 miles N-W of Picayune
 (distance) (direction) (nearest town)

WELL PURPOSE: water
 (home, irrigation, municipal, industrial)

- WELL COMPLETION DATA:
- (1) diameter (inches) 2 1/2"
 - (2) total depth (feet) 300 ft
 - (3) static water level (feet) 8 below/above top of ground.
 - (4) casing galv. (material), 295' (depth)
2" (size) if telescope see back.
 - (5) screen 2 1/2" (length), 295' (depth to top)
2 1/2" (size), galv. (material)
 - (6) pump 1/2 (HP), 540 (yield gpm)
elect (type power)
 - (7) electric log No (yes or no)
- (organization running log)
- (8) how well bottom plugged hard

CODED


DEC 11 1972

DRILLERS REMARKS:

MISS. BD. OF
 WATER COMMISSIONERS

If well telescopes please sketch and show depths.

GROUND LEVEL

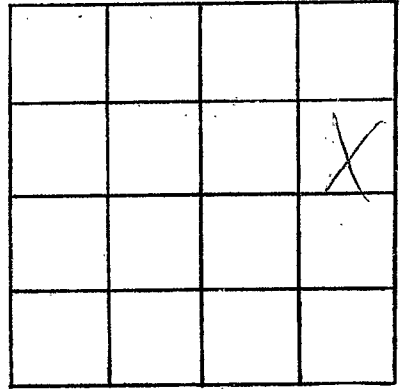

SECTION _____

Please indicate well location X.

ADDITIONAL INFORMATION

If more than one screen,
show locations of each on sketch.