

PEARL RIVER
P 50
4-30-73

MISSISSIPPI
BOARD OF WATER COMMISSIONERS
416 North State Street
Jackson, Mississippi 39201

CODED

WATER WELL DRILLERS LOG

4/30 1973 Bud Peterson Son Pearl River
date well completed firm name county well located

LANDOWNER: J. G. Riboux

A. T. Carriere Miss

description of formations encountered	from	to
white shale	0	31
white sand	31	43
blue shale	43	182
blue sand	182	224

(mailing address)

WELL LOCATION:
sec. 12 T. 4 N R. 17 E
3 miles West of Carriere
(distance) (direction) (nearest town)

WELL PURPOSE: home
(home, irrigation, municipal, industrial)

WELL COMPLETION DATA:

- (1) diameter (inches) 4"
- (2) total depth (feet) 225
- (3) static water level (feet) 105 below above top of ground.
- (4) casing PVC, 2 1/2" (material), (depth)
(size) if telescope see back.
- (5) screen 4 x 10, 24" (length), (depth to top)
4" PVC 7012 (size), (material)
- (6) pump 1 (HP) 650 (yield gpm)
Elect. (type power)
- (7) electric log (yes or no)
- (organization running log)
- (8) how well bottom plugged sand
sharp


CODED

DRILLERS REMARKS:

MISSISSIPPI BOARD OF WATER COMMISSIONERS

If well telescopes please sketch and show depths.

GROUND LEVEL

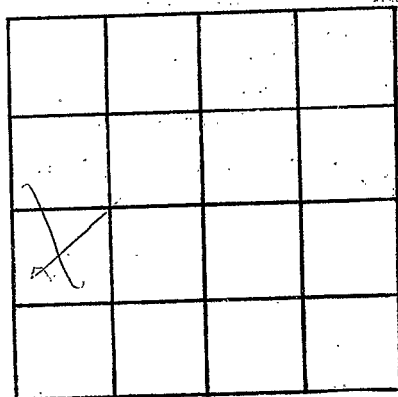

SECTION _____

Please indicate well location X.

ADDITIONAL INFORMATION

If more than one screen,
show locations of each on sketch.