

PEARL RIVER
P 51
4-7-73

MISSISSIPPI
 BOARD OF WATER COMMISSIONERS
 416 North State Street
 Jackson, Mississippi 39201

CODED

WATER WELL DRILLERS LOG

4/7 1973 Bed Ponton & Son Pearl River
 date well completed firm name county well located

LANDOWNER: H.A. Talgoose
B.T. Carriere
Mitt
 (mailing address)

description of formations encountered	from	to
<u>Red shale</u>	<u>0</u>	<u>19</u>
<u>White sand</u>	<u>19</u>	<u>81</u>
<u>Blue shale</u>	<u>18</u>	<u>220</u>
<u>Blue sand</u>	<u>220</u>	<u>280</u>

WELL LOCATION:
 sec 21 T 4 N R 17 E
9 miles SW of Carriere
 (distance) (direction) (nearest town)

WELL PURPOSE: home
 (home, irrigation, municipal, industrial)

- WELL COMPLETION DATA:
- (1) diameter (inches) 4"
 - (2) total depth (feet) 280
 - (3) static water level (feet) 91 below above ground.
 - (4) casing pvc 270
 (material) (depth)
 if telescope see back.
 (size)
 - (5) screen 10 ft 270
 (length) (depth to top)
4x10 pvc mesh
 (size) (material)
 - (6) pump 1 1/2 270
 (HP) (yield gpm)
Elect
 (type power)
 - (7) electric log
 (yes or no)

 (organization running log)
 - (8) how well bottom plugged packed
shards


CODED

DRILLERS REMARKS:

APR 21 1973

If well telescopes please sketch and show depths.

GROUND LEVEL

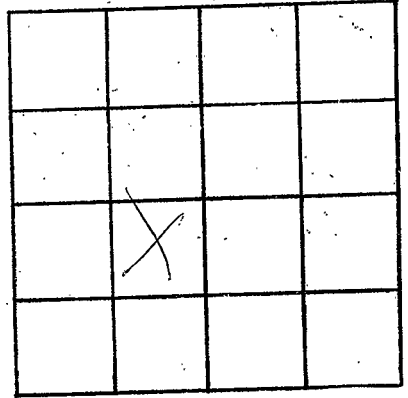

SECTION _____

Please indicate well location X.

ADDITIONAL INFORMATION

If more than one screen, show locations of each on sketch.