

Pearl River  
P 52  
6-18-73

MISSISSIPPI  
 BOARD OF WATER COMMISSIONERS  
 416 North State Street  
 Jackson, Mississippi 39201

**CODED**

WATER WELL DRILLERS LOG

6-18 1973 Horace A Poole Pearl River  
 date well completed firm name county well located

LANDOWNER	description of formations encountered	from	to
<u>Jessie Broadhead</u>	<u>Surface Clay</u>	<u>0</u>	<u>10</u>
<u>RT# 2</u>	<u>Clay</u>	<u>10</u>	<u>20</u>
<u>Carriette</u>	<u>SAND + GRAVEL</u>	<u>20</u>	<u>42</u>
(mailing address)			

WELL LOCATION:  
 sec 36 T 4 S R 17 E W  
10 miles NW of Preyone  
 (distance) (direction) (nearest town)

WELL PURPOSE: Home  
 (home, irrigation, municipal, industrial)

- WELL COMPLETION DATA:
- (1) diameter (inches) 4 1/4
  - (2) total depth (feet) 42
  - (3) static water level (feet) 20 below above top of ground.
  - (4) casing PVC, 37  
 (material) (depth)  
2" if telescope see back.  
 (size)
  - (5) screen 5, 37  
 (length) (depth to top)  
2, PVC  
 (size) (material)
  - (6) pump 1/2 5  
 (HP) (yield gpm)  
Electric  
 (type power)
  - (7) electric log no  
 (yes or no)
- (organization running log)
- (8) how well bottom plugged Back Wash Valve


**CODED**

JUN 29 1973

DRILLERS REMARKS: \_\_\_\_\_

If well telescopes please sketch and show depths.

GROUND LEVEL

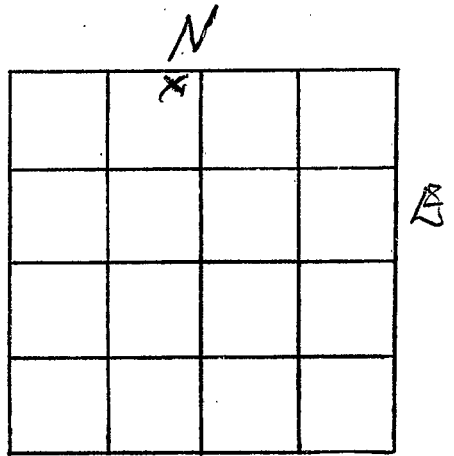

S  
SECTION 36

Please indicate well location X.

ADDITIONAL INFORMATION

If more than one screen, show locations of each on sketch.