

MISSISSIPPI  
BOARD OF WATER COMMISSIONERS  
416 North State Street  
Jackson, Mississippi 39201

**CODED**

WATER WELL DRILLERS LOG

PEARL RIVER  
P 53  
6-19-73

6-19- 1973 Horace A Poole Pearl River  
date well completed firm name county well located

LANDOWNER: R.A. Burke  
RT # 1  
Carriere  
(mailing address)

description of formations encountered	from	to
<u>Surface Clay</u>	<u>0</u>	<u>12</u>
<u>Clay</u>	<u>12</u>	<u>36</u>
<u>Sand</u>	<u>36</u>	<u>60</u>

WELL LOCATION:  
sec. 26 T 4 S R 17 W  
10 miles NW of Siagon  
(distance) (direction) (nearest town)

WELL PURPOSE: Home  
(home, irrigation, municipal, industrial)

- WELL COMPLETION DATA:
- (1) diameter (inches) 4 1/2
  - (2) total depth (feet) 65
  - (3) static water level (feet) 40 below top of ground.
  - (4) casing Pvc 60  
(material) (depth)
  - 2 if telescope see back.  
(size)
  - (5) screen 5 60  
(length) (depth to top)
  - 2 Pvc  
(size) (material)
  - (6) pump 1 4  
(HP) (yield gpm)
  - Sleeve  
(type power)
  - (7) electric log No  
(yes or no)
- (organization running log)

**CODED**


(8) how well bottom plugged  
BW Nature

DRILLERS REMARKS:

2011 02 01 15:03

If well telescopes please sketch and show depths.

GROUND LEVEL

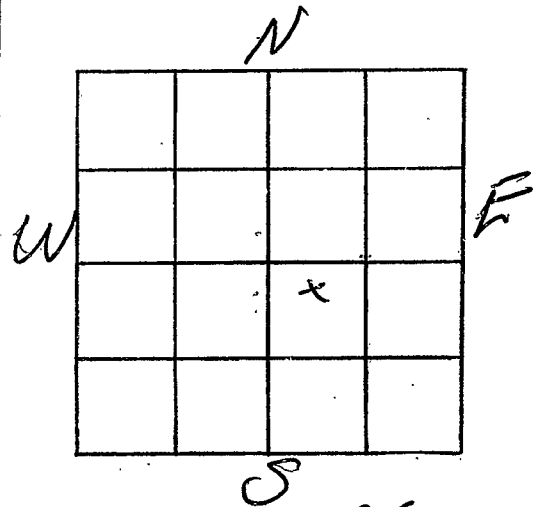

SECTION 26

Please indicate well location X.

ADDITIONAL INFORMATION

If more than one screen, show locations of each on sketch.