

Pearl River
P 54
7-19-73

MISSISSIPPI
BOARD OF WATER COMMISSIONERS
416 North State Street
Jackson, Mississippi 39201

CODED

WATER WELL DRILLERS LOG

7-19-1973 date well completed
Horace A Poole firm name
Pearl River county well located

LANDOWNER: A. HANKIE
CARRIERS MICH
(mailing address)

description of formations encountered	from	to
Surface Clay	0	12
Sand & Clay	12	20
SAND	20	36
Clay	36	290
SAND	190	231

WELL LOCATION:
sec. 2 T 4 N R 17 E
16 miles SW of Poplarville
(distance) (direction) (nearest town)

WELL PURPOSE:
(home, irrigation, municipal, industrial)

- WELL COMPLETION DATA:
- (1) diameter (inches) 4 1/2
 - (2) total depth (feet) 231
 - (3) static water level (feet) 1 below above top of ground.
 - (4) casing PVC 216
(material) (depth)
2" if telescope see back.
(size)
 - (5) screen 15" 216
(length) (depth to top)
2" O.D. PVC
(size) (material)
 - (6) pump _____ (HP) _____ (yield gpm)
(type power)
 - (7) electric log _____ (yes or no)
(organization running log)
 - (8) how well bottom plugged _____
BW, VAPOR


CODED

DRILLERS REMARKS:
NO PRESSURE

AUG 3 1973

If well telescopes please sketch and show depths.

GROUND LEVEL

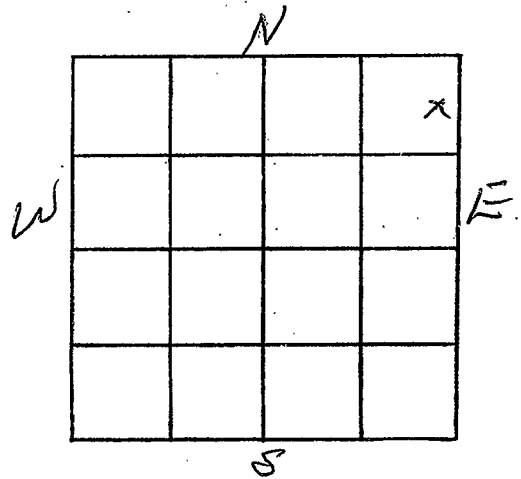

SECTION 2-4-17

Please indicate well location X.

ADDITIONAL INFORMATION

If more than one screen,
show locations of each on sketch.