

P 55
PEARL RIVER
7-11-73

MISSISSIPPI
BOARD OF WATER COMMISSIONERS
416 North State Street
Jackson, Mississippi 39201

CODED

WATER WELL DRILLERS LOG

7/11 1973 Bud Porter & Son Pearl River
date well completed firm name county well located

LANDOWNER: J.B. Landry

description of formations encountered	from	to
Red shale	0	16
Rocks	16	24
Blue shale	24	196
Gray sand	196	255

Ac. 1 carrier Miss.

(mailing address)

WELL LOCATION:

sec 21 T 5 N R 17 E
2 miles West of Carriere
(distance) (direction) (nearest town)

WELL PURPOSE: home
(home, irrigation, municipal, industrial)

WELL COMPLETION DATA:


- (1) diameter (inches) 2"
- (2) total depth (feet) 255
- (3) static water level (feet) 57 below above top of ground.
- (4) casing 900' 250'
(material) (depth)
If telescope see back.
(size)
- (5) screen 255' 250'
(length) (depth to top)
12' 900'
(size) (material)
- (6) pump 1 650
(HP) (yield gpm)
Elect
(type power)
- (7) electric log no
(yes or no)
- (organization running log)
- (8) how well bottom plugged sharp

DRILLERS REMARKS:

AUG 12 1973

If well telescopes please sketch and show depths.

GROUND LEVEL

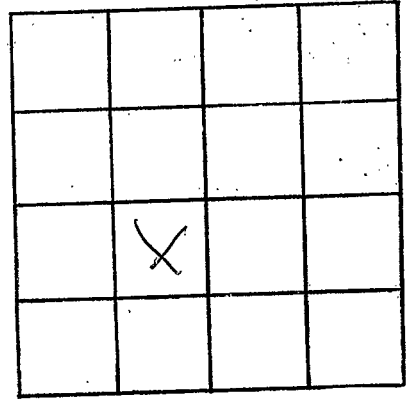

SECTION _____

Please indicate well location X.

ADDITIONAL INFORMATION

If more than one screen, show locations of each on sketch.