

P.R.
P 56
12-7-73

Walter Penton

MISSISSIPPI
BOARD OF WATER COMMISSIONERS
416 North State Street
Jackson, Mississippi 39201

CODED

WATER WELL DRILLERS LOG

12-7-73 date well completed
1973 Penton Well Serv firm name
Pearl River county well located

LANDOWNER: C.R. Jarrell
St. 1
Carriere Miss
(mailing address)

description of formations encountered	from	to
Surface Clay	0	17
Sand	17	20
Blue Clay	20	210
Sand	210	480
Blue Clay	480	700
Sand	700	810
Blue Clay	810	820
Sand	820	902

WELL LOCATION:
sec. 33 T. 4 S. R. 17 W.
1 miles South of Mill Creek
(distance) (direction) (nearest town)

WELL PURPOSE: Home
(home, irrigation, municipal, industrial)

- WELL COMPLETION DATA:
- (1) diameter (inches) 2"
 - (2) total depth (feet) 902
 - (3) static water level (feet) 22 below top of ground.
 - (4) casing Galv 882
(material) (depth)
 - 2 if telescope see back.
(size)
 - (5) screen 20' 882
(length) (depth to top)
 - 2 S. Steel
(size) (material)
 - (6) pump 1 13
(HP) (yield gpm)
 - Elec
(type power)
 - (7) electric log No
(yes or no)
 - (organization running log)
 - (8) how well bottom plugged BW Valve

CODED

DISCONTINUED


JAN 16 1974

DRILLERS REMARKS:

MISS. BD. OF WATER

If well telescopes please sketch and show depths.

GROUND LEVEL

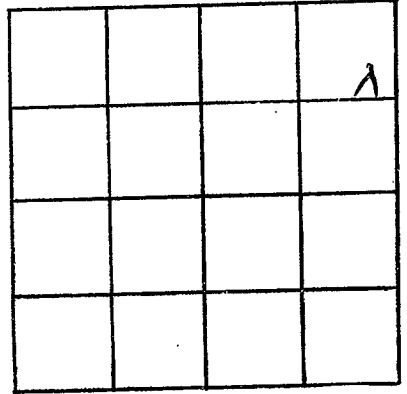

SECTION 33

Please indicate well location X.

ADDITIONAL INFORMATION

If more than one screen, show locations of each on sketch.