

Pearl R.
 P 58
 2-18-74

MISSISSIPPI
 BOARD OF WATER COMMISSIONERS
 416 North State Street
 Jackson, Mississippi 39201

CODED

WATER WELL DRILLERS LOG

Feb. 18 1974 Harold Woodward Pearl River
 date well completed firm name county well located

LANDOWNER: Vito Ziggardo
H. I. Comm. Miss.
 (mailing address)
 WELL LOCATION:
 sec. 7 T 4 N R 17 E
5 miles North Franklin
 (distance) (direction) (nearest town)

WELL PURPOSE: Home
 (home, irrigation, municipal, industrial)

WELL COMPLETION DATA:
 (1) diameter (inches) 2"
 (2) total depth (feet) 220
 (3) static water level (feet) 17 below top of ground.
 (4) casing plastic 210'
 (material) (depth)
 (size) If telescope see back:
 (5) screen 10' 210'
 (length) (depth to top)
2" plastic
 (size) (material)
 (6) pump 1/2 10
 (HP) (yield gpm)
USAC
 (type power)
 (7) electric log NO
 (yes or no)
Self
 (organization running log)
 (8) how well bottom plugged 3" screen
B.W. dev


description of formations encountered	from	to
Red Clay	0	7
White Clay	7	12
fine sand	12	28
Blue Clay	29	105
fine sand	105	108
blue clay	108	168
fine sand	168	175
Very good sand		
and gravel	175	210
set at 220 ft		

DRILLERS REMARKS:

FEB 26 1974
 MISS. BD. OF WATER COMM.

If well telescopes please sketch and show depths.

GROUND LEVEL

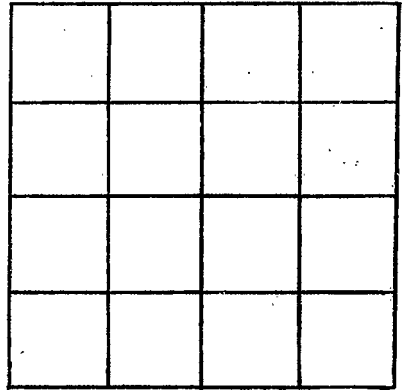

SECTION _____

Please indicate well location X.

ADDITIONAL INFORMATION

If more than one screen,
show locations of each on sketch.