

**MISSISSIPPI
BOARD OF WATER COMMISSIONERS**
416 North State Street
Jackson, Mississippi 39201

CODED

WATER WELL DRILLERS LOG

Pearl R.
P 59
2-17-74

Feb. 17 1974 Harold Woodrum Wetzel Pearl River
date well completed firm name county well located

LANDOWNER: Dan Egan
Wt. 1 Pearl River
Carver, Miss.
(mailing address)

WELL LOCATION:
sec. 7 T 4 N R 12 S W
(distance) miles of (direction) (nearest town)

WELL PURPOSE:
(home, irrigation, municipal, industrial)

WELL COMPLETION DATA:
(1) diameter (inches) 2"
(2) total depth (feet) 230'
(3) static water level (feet) 17 below top of ground.
(4) casing plastic 220' (material) (depth)
(size) If telescope see back.
(5) screen 10" 220' (length) (depth to top)
2" plastic (size) (material)
(6) pump 1/2 10 (HP) (yield gpm)
115 AC (type power)
(7) electric log no (yes or no)
Self (organization running log)
(8) how well bottom plugged 2" galvanized
Pearl River


description of formations encountered	from	to
<u>Red clay</u>	<u>0</u>	<u>7</u>
<u>White clay</u>	<u>7</u>	<u>12</u>
<u>fine sand</u>	<u>12</u>	<u>22</u>
<u>Blue clay</u>	<u>22</u>	<u>105</u>
<u>fine sand</u>	<u>105</u>	<u>108</u>
<u>blue clay</u>	<u>108</u>	<u>168</u>
<u>fine sand</u>	<u>168</u>	<u>175</u>
<u>Very good sand</u>	<u>175</u>	<u>189</u>
<u>Very dense sand & gravel</u>	<u>189</u>	<u>231</u>
<u>Set at 230'</u>		

DRILLERS REMARKS:

FEB 20 1974
MISS. BD. OF WATER

If well telescopes please sketch and show depths.

GROUND LEVEL

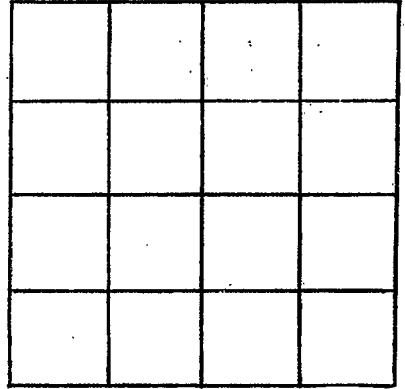

SECTION _____

Please indicate well location X.

ADDITIONAL INFORMATION

If more than one screen,
show locations of each on sketch.