

MISSISSIPPI  
 BOARD OF WATER COMMISSIONERS  
 416 North State Street  
 Jackson, Mississippi 39201 **CODED**

**WATER WELL DRILLERS LOG**

**Pearl R.**  
**P 60**  
**1-7-74**

1-7-74 date well completed      1974 Budington Son Pearl River firm name      county well located

LANDOWNER Arthur Smith  
B. T. Carrier  
 (mailing address)

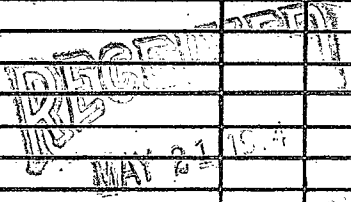
description of formations encountered	from	to
Red shale	0	18
Red sand	18	90
<del>Red shale</del>	<del>90</del>	<del>175</del>
Yellow shale	90	175
White sand shale	175	210
Blue shale	210	280
Gray shale	280	300

WELL LOCATION:  
 sec 19 T 4 N R 17 E  
1/4 miles NW of Carrier  
 (distance) (direction) (nearest town)

WELL PURPOSE: home  
 (home, irrigation, municipal, industrial)

- WELL COMPLETION DATA:
- (1) diameter (inches) 4"
  - (2) total depth (feet) 300
  - (3) static water level (feet) 161 below/above top of ground.
  - (4) casing PVC 300  
 (material) (depth)
  - \_\_\_\_\_ if telescope see back.  
 (size)
  - (5) screen 4x10 290  
 (length) (depth to top)
  - 1 1/2 \_\_\_\_\_  
 (size) (material)
  - (6) pump 1 650  
 (HP) (yield gpm)
  - Electric  
 (type power)
  - (7) electric log no  
 (yes or no)
  - \_\_\_\_\_ (organization running log)
  - (8) how well bottom plugged dark shale

**CODED**

  
 MAY 21 1974

DRILLERS REMARKS:

MISS. BD. OF WATER

If well telescopes please sketch and show depths.

GROUND LEVEL

X			

SECTION \_\_\_\_\_

Please indicate well location X.

ADDITIONAL INFORMATION

If more than one screen, show locations of each on sketch.