

P.R.
 P62
 7-1-74

MISSISSIPPI
 BOARD OF WATER COMMISSIONERS
 416 North State Street
 Jackson, Mississippi 39201

WATER WELL DRILLERS LOG

Pearl River

7-1 date well completed
 1974 Earl B. Penton water well serv. firm name
 county well located

LANDOWNER:
 Virgil Alexander
 Rt. 1 Carriere Miss.
 (mailing address)

description of formations encountered	from	to
Red clay	0	12
White Fine sd.	12	20
white clay	20	30
Blue clay	30	106
Fine Blue sd.	106	176
Coarse Gray sd.	176	192

WELL LOCATION:
 sec. ~~24~~ T 4 N R 17 E 13V
 6 miles N.W. of Mermentau
 (distance) (direction) (nearest town)

WELL PURPOSE: DOMESTIC
 (home, irrigation, municipal, industrial)

- WELL COMPLETION DATA:
- (1) diameter (inches) 4 5/8
 - (2) total depth (feet) 192
 - (3) static water level (feet) 14 below/above top of ground
 - (4) casing P.V.C. 187
 (material) (depth)
5' if telescope see back.
 (size)
 - (5) screen 5' 187
 (length) (depth to top)
2" P.V.C.
 (size) (material)
 - (6) pump 1/2 450 P.A.
 (HP) (yield gpm)
Elect.
 (type power)
 - (7) electric log NO
 (yes or no)
 - (organization running log)
 - (8) how well bottom plugged Skoe

CODED


MISSISSIPPI BOARD OF WATER COMMISSIONERS
 FEB 18 1975

DRILLERS REMARKS:

MISS. BD. OF WATER COMMISSIONERS

If well telescopes please sketch and show depths.

GROUND LEVEL

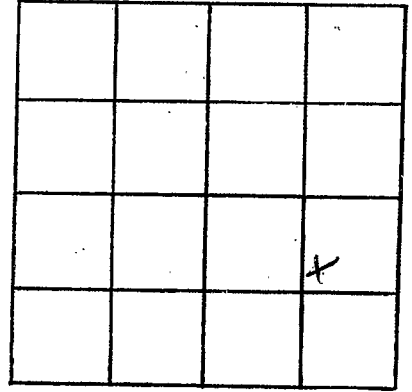

SECTION 24

Please indicate well location X.

ADDITIONAL INFORMATION

If more than one screen, show locations of each on sketch.