

Pearl River  
 P63  
 2-17-75

MISSISSIPPI  
 BOARD OF WATER COMMISSIONERS  
 416 North State Street  
 Jackson, Mississippi 39201

CODED

WATER WELL DRILLERS LOG

2-17  
 date well completed

1975 Penton Well Serv  
 firm name

Pearl River  
 county well located


LANDOWNER: <u>Donald Oldmixon</u> <u>A. 3</u>	description of formations encountered	from	to
<u>Paplarville Miss.</u> (mailing address)	<u>Surface Clay</u>	<u>0</u>	<u>22</u>
	<u>Blue Clay</u>	<u>22</u>	<u>168</u>
	<u>Sand</u>	<u>168</u>	<u>199</u>
WELL LOCATION: sec. <u>2</u> T. <u>4</u> S. R. <u>17</u> E <u>5</u> miles <u>West</u> of <u>Millard</u> (distance) (direction) (nearest town)			
WELL PURPOSE: <u>Home</u> (home, irrigation, municipal, industrial)			
WELL COMPLETION DATA:			
(1) diameter (inches) <u>2</u>			
(2) total depth (feet) <u>199</u>			
(3) static water level (feet) <u>29</u> below top of ground.			
(4) casing <u>Czlu</u> , <u>189</u> , (material) (depth)			
<u>2</u> If telescope see back. (size)			
(5) screen <u>10'</u> , <u>189</u> (length) (depth to top)			
<u>2</u> , <u>S. Steel</u> (size) (material)			
(6) pump <u>1</u> <u>12</u> (HP) (yield gpm)			
<u>Elec</u> (type power)			
(7) electric log <u>NO</u> (yes or no)			
(organization running log)			
(8) how well bottom plugged <u>B.W. Valve</u>			
DRILLERS REMARKS:			

CODED

RECEIVED  
 APR 10 1975

If well telescopes please sketch and show depths.

GROUND LEVEL

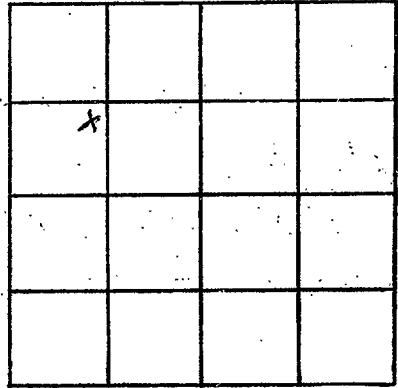

SECTION 2

Please indicate well location X.

ADDITIONAL INFORMATION

If more than one screen, show locations of each on sketch.