

Pearl R.
P 65
7/78

MISSISSIPPI
BOARD OF WATER COMMISSIONERS
416 North State Street
Jackson, Mississippi 39201

WATER WELL DRILLERS LOG

date well completed 19 78 firm name Bud Pentecost county well located Pearl River

LANDOWNER:
Bill Archie
Carrine, Mo.
(mailing address)

WELL LOCATION:
sec 27 T 4 N R 17 E
4 miles W of Carrine
(distance) (direction) (nearest town)

WELL PURPOSE: Home
(home, irrigation, municipal, industrial)

WELL COMPLETION DATA:

(1) diameter (inches) 2 in
(2) total depth (feet) 716
(3) static water level (feet) 12 below above top of ground.
(4) casing PVC 716
(material) (depth)
(size) if telescope see back.
(5) screen 2x30 685
(length) (depth to top)
12 PVC
(size) (material)
(6) pump NO
(HP) (yield gpm)
(type power)
(7) electric log _____
(yes or no)
(organization running log)
(8) how well bottom plugged Sand Shale


description of formations encountered	from	to
<u>White Shale</u>	<u>0</u>	<u>20</u>
<u>White Sand</u>	<u>20</u>	<u>80</u>
<u>Blue Shale</u>	<u>80</u>	<u>216</u>
<u>Grey Sand</u>	<u>216</u>	<u>300</u>
<u>Blue Shale</u>	<u>300</u>	<u>680</u>
<u>Grey Sand</u>	<u>680</u>	<u>716</u>

DRILLERS REMARKS:

RECEIVED
JUL 31 1978

If well telescopes please sketch and show depths.

GROUND LEVEL

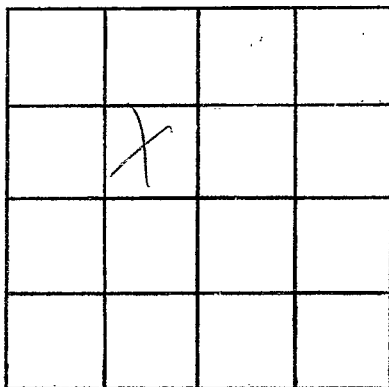

SECTION _____

Please indicate well location X.

ADDITIONAL INFORMATION

If more than one screen,
show locations of each on sketch.