

Pearl River  
P66  
3/8/79

MISSISSIPPI  
BOARD OF WATER COMMISSIONERS  
416 North State Street  
Jackson, Mississippi 39201

CODED

WATER WELL DRILLERS LOG

3/8 date well completed 1979 Bid Benton firm name Pearl River county well located

LANDOWNER: Clyde Benton  
B.T. Bet  
(mailing address)  
WELL LOCATION:  
sec. 27 T 4 N R 17 E  
3 miles W of McNeil  
(distance) (direction) (nearest town)

description of formations encountered	from	to
Red Shale	0	22
White sand	22	30
Blue shale	30	375
Blue sand	375	380
Blue shale	380	625
Brk sand	625	732

CODED

WELL PURPOSE: home  
(home, irrigation, municipal, industrial)

WELL COMPLETION DATA:  
(1) diameter (inches) 2"  
(2) total depth (feet) 732  
(3) static water level (feet) 16" below above top of ground.  
(4) casing PVC, 732, (material) (depth)  
(size) if telescope see back.  
(5) screen 2x30, 702, (length) (depth to top)  
12, PVC (size) (material)  
(6) pump 30 (HP) (yield gpm)  
(type power)  
(7) electric log NO (yes or no)  
(organization running log)  
(8) how well bottom plugged Sand

DRILLERS REMARKS:


Miss. Board of Water Comm.

JUL 30 1979

RECEIVED

If well telescopes please sketch and show depths.

GROUND LEVEL

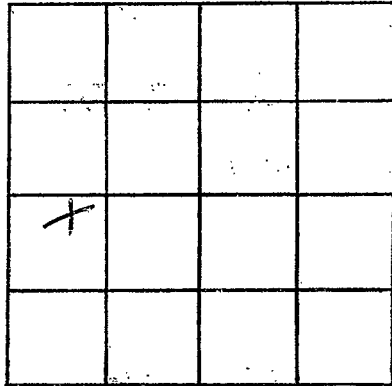

SECTION \_\_\_\_\_

Please indicate well location X.

ADDITIONAL INFORMATION

If more than one screen, show locations of each on sketch.