

MISSISSIPPI DEPARTMENT OF NATURAL RESOURCES

Bureau of Land and Water Resources

Southport Mall

P.O. Box 10631

Jackson, Mississippi 39209

BUD PENTON & SON
WATER WELL SERVICE
ROUTE 4 BOX 402
CARRIERE, MS 39426
PHONE 798-5324

CODED

WATER WELL DRILLERS LOG

BUD PENTON & SON
WATER WELL SERVICE
ROUTE 4 BOX 402
CARRIERE, MS 39426
PHONE 798-5324

PEARL RIVER
P P 72
4/4/83

4/4 1983
date well completed

firm name

Pearl River
county well located

LANDOWNER: Jack Russ

P.T. 5 Poplarville

(mailing address)

WELL LOCATION:

sec. 24 T-4 N R-17 E
S W
1/4 miles West of Poplarville
(distance) (direction) (nearest town)

WELL PURPOSE: home
(home, irrigation, municipal, industrial)

WELL COMPLETION DATA:

- (1) diameter (inches) 2"
- (2) total depth (feet) 1241
- (3) static water level (feet) 80 below above top of ground.
- (4) casing PVC, 1241, (material) (depth)
- (size) if telescope see back.
- (5) screen 2x15, 1226 (length) (depth to top)
- 12, PVC (size) (material)
- (6) pump 2, 580 (HP) (yield gpm)
- Elect. (type power)
- (7) electric log no (yes or no)

(organization running log)

(8) how well bottom plugged sand
stark

DRILLERS REMARKS:

description of formations encountered

from to

Red shale	0	15
Red sand	15	20
Gray sand	60	110
Blue shale	210	420
Gray sand	420	600
Blue shale	600	680
Gray sand	680	640
Blue shale	640	1145
Gray sand	1145	1241

CODED


DEPT. OF NATURAL RESOURCES
BUREAU OF LAND & WATER RESOURCES

APR 27 1983

RECEIVED

If well telescopes please
sketch and show depths.

GROUND LEVEL

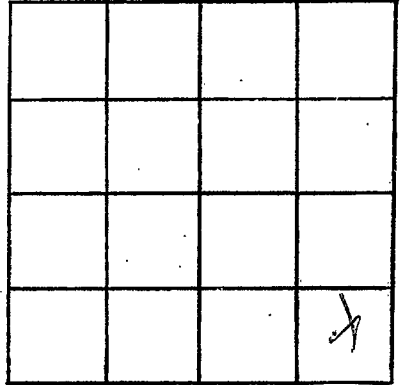

SECTION _____

Please indicate well location X.

ADDITIONAL INFORMATION

If more than one screen,
show locations of each on sketch.