

MISSISSIPPI DEPARTMENT OF NATURAL RESOURCES

Bureau of Land and Water Resources

PEARL RIVER
P 73
12/16/83

CODED

Southport Mall

WATER WELL SERVICE
ROUTE 4 BOX 102
CARRIERE, MS 39426
PHONE 798-5324

P.O. Box 10631

Mississippi 39209

BUD PENTON & SON
WATER WELL SERVICE
WATER WELL DRILLERS LOG

CARRIERE, MS 39426
PHONE 798-5324

12/16

1983

date well completed

firm name

county well located

Pearl River

LANDOWNER: Mr. Plomer

RT

description of formations encountered

from to

Red shale
Red sand
Blue shale
Gray sand

0 42
42 90
90 300
300 343

(mailing address)

WELL LOCATION:

sec. 28 T. 4 N. R. 17 E.
S. W.
7 miles West of Carriere
(distance) (direction) (nearest town)

WELL PURPOSE: home
(home, irrigation, municipal, industrial)

WELL COMPLETION DATA:

- (1) diameter (inches) 4
- (2) total depth (feet) 343
- (3) static water level (feet) 135 below top of ground.
- (4) casing PVC, 343 (material) (depth)
- (size) If telescope see back.
- (5) screen 4x20, 323 (length) (depth to top)
- 12, PVC (size) (material)
- (6) pump 5 HP, 4800 (HP) (yield-gpm)
- Elect 9PH (type power)
- (7) electric log (yes or no)

CODED

DEPT. OF NATURAL RESOURCES
BUREAU OF LAND & WATER RESOURCES

APR 27 1983

RECEIVED


(organization running log)

(8) how well bottom plugged sand

DRILLERS REMARKS:

If well telescopes please sketch and show depths.

GROUND LEVEL

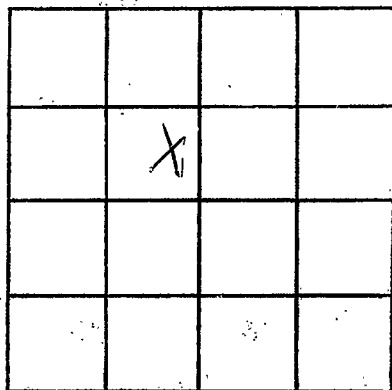

SECTION _____

Please indicate well location X.

ADDITIONAL INFORMATION

If more than one screen,
show locations of each on sketch.