

MISSISSIPPI DEPARTMENT OF NATURAL RESOURCES

Bureau of Land and Water Resources

Southport Mall

P.O. Box 10631

Jackson, Mississippi 39209

WATER WELL DRILLERS LOG

Pearl R.  
P 78  
5-2-85

WELDER WELDING

PK

5-2-1985 date well completed

firm name

county well located

LANDOWNER: SAVARESE

description of formations encountered

from to

R.T. 1

CARRIERE

(mailing address)

CLAY

0 21

SAND

21 33

CLAY

33 44

SAND

44 123

WELL LOCATION:

sec. 29 T 4 S R 17 W  
7 miles W of MEMPHIS  
(distance) (direction) (nearest town)

WELL PURPOSE: HOME  
(home, irrigation, municipal, industrial)

WELL COMPLETION DATA:

- (1) diameter (inches) 2
- (2) total depth (feet) 123
- (3) static water level (feet) 41 below above top of ground.
- (4) casing PVC 123 (material) (depth)  
(size) if telescope see back.
- (5) screen 10 113 (length) (depth to top)  
2 PVC (size) (material)
- (6) pump 1 10 (HP) (yield gpm)  
ELEC (type power)
- (7) electric log (yes or no)  
(organization running log)
- (8) how well bottom plugged SANDSARK

RECEIVED


MAY 10 1985

DRILLERS REMARKS:

Department of Natural Resources  
Bureau of Land & Water Resources

If well telescopes please sketch and show depths.

GROUND LEVEL

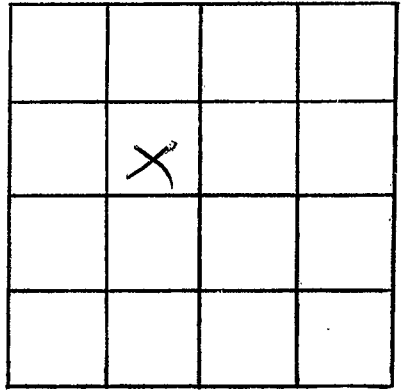

SECTION \_\_\_\_\_

Please indicate well location X.

ADDITIONAL INFORMATION

Lined area for additional information, consisting of approximately 20 horizontal lines.

If more than one screen, show locations of each on sketch.