

MISSISSIPPI DEPARTMENT OF NATURAL RESOURCES

Bureau of Land and Water Resources

Southport Mall

P.O. Box 10631

Jackson, Mississippi 39209

WATER WELL DRILLERS LOG

WALKERS WELDING

Pearl R.
P 79
5-7-85

5-7 1985 ~~Walker Welding~~ PR
date well completed firm name county well located

| LANDOWNER: <u>MR. RAJKA JR.</u> <u>Box 630 CERD.</u> | description of formations encountered | from | to |
|---|---------------------------------------|------------|------------|
| <u>SLIDEN, LA.</u> (mailing address) | <u>CLAY</u> | <u>0</u> | <u>36</u> |
| WELL LOCATION: | <u>SAND</u> | <u>36</u> | <u>42</u> |
| ? sec. <u>17</u> T <u>4</u> N R <u>17</u> e S W <u>9</u> miles <u>W</u> of <u>MENEIL</u> (distance) (direction) (nearest town) | <u>CLAY</u> | <u>42</u> | <u>85</u> |
| WELL PURPOSE: <u>HOME</u> (home, irrigation, municipal, industrial) | <u>SAND</u> | <u>85</u> | <u>92</u> |
| WELL COMPLETION DATA: | <u>CLAY</u> | <u>92</u> | <u>202</u> |
| (1) diameter (inches) <u>4</u> | <u>SAND</u> | <u>202</u> | <u>230</u> |
| (2) total depth (feet) <u>230</u> | | | |
| (3) static water level (feet) <u>120</u> below above top of ground. | | | |
| (4) casing <u>Pvc</u> , <u>230</u> , (material) (depth) | | | |
| _____ if telescope see back. (size) | | | |
| (5) screen <u>10</u> , <u>220</u> (length) (depth to top) | | | |
| <u>4</u> , <u>Pvc</u> (size) (material) | | | |
| (6) pump <u>1/2</u> , <u>8</u> (HP) (yield gpm) | | | |
| <u>ELEC.</u> (type power) | | | |
| (7) electric log _____ (yes or no) | | | |
| _____ (organization running log) | | | |
| (8) how well bottom plugged <u>SAND SHARK</u> | | | |
| DRILLERS REMARKS: | | | |


RECEIVED

MAY 10 1985

Department of Natural Resources
Bureau of Land & Water Resources

If well telescopes please sketch and show depths.

GROUND LEVEL

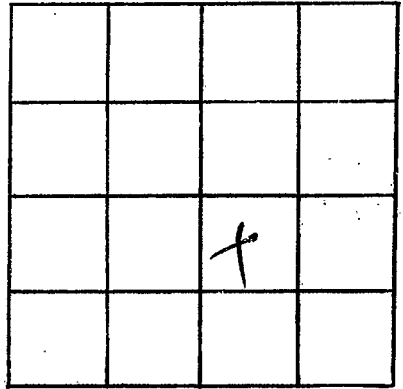

SECTION _____

Please indicate well location X.

ADDITIONAL INFORMATION

If more than one screen,
show locations of each on sketch.