

MISSISSIPPI DEPARTMENT OF NATURAL RESOURCES

Bureau of Land and Water Resources

Southport Mall

P.O. Box 10631

Jackson, Mississippi 39209

WATER WELL DRILLERS LOG

CODED

PEARL RIVER  
P 80

6-19 1985 WALKERS WELDING PR  
date well completed firm name county well located

LANDOWNER: <u>CHARD NURSERY</u>	description of formations encountered	from	to
<u>RTI</u>			
<u>CARRIERS MS.</u> (mailing address)	<u>SAND</u>	<u>20</u>	<u>28</u>
	<u>CLAY</u>	<u>28</u>	<u>73</u>
WELL LOCATION: sec. <u>11</u> T <u>4</u> S R <u>17</u> E <u>5</u> miles <u>N.W.</u> <u>MC NEIL</u> (distance) (direction) (nearest town)	<u>SAND</u>	<u>73</u>	<u>86</u>
	<u>CLAY</u>	<u>86</u>	<u>128</u>
	<u>SAND</u>	<u>128</u>	<u>172</u>
WELL PURPOSE: <u>IRRIGATION</u> (home, irrigation, municipal, industrial)			
WELL COMPLETION DATA:			
(1) diameter (inches) <u>4</u>			
(2) total depth (feet) <u>172</u>			
(3) static water level (feet) <u>93</u> below top of ground.			
(4) casing <u>Pre</u> <u>172</u> (material) (depth)			
(size) If telescope see back.			
(5) screen <u>20'</u> <u>152</u> (length) (depth to top)			
<u>4"</u> (size) (material)			
(6) pump <u>5</u> <u>60</u> (HP) (yield gpm)			
<u>ELEC.</u> (type power)			
(7) electric log (yes or no)			
(organization running log)			
(8) how well bottom plugged <u>Sand shank</u>			

CODED

RECEIVED


JUN 25 1985

DRILLERS REMARKS:

Department of Natural Resources  
Bureau of Land & Water Resources

If well telescopes please sketch and show depths.

GROUND LEVEL

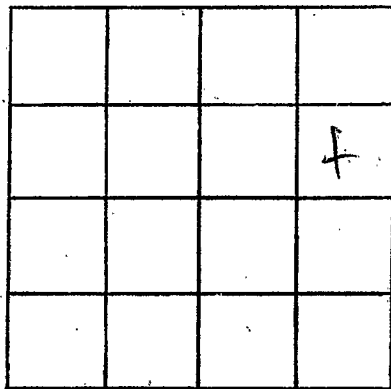

SECTION \_\_\_\_\_

Please indicate well location X.

ADDITIONAL INFORMATION

If more than one screen,  
show locations of each on sketch.