

MISSISSIPPI DEPARTMENT OF NATURAL RESOURCES

Bureau of Land and Water Resources

Southport Mall

P.O. Box 10631

Jackson, Mississippi 39209

WATER WELL DRILLERS LOG

CODED

PEARL RIVER
P 81

5-30-85 date well completed WALKERS WELDING firm name PR county well located

LANDOWNER: CHANDRO NURSERY

description of formations encountered	from	to
CLAY	0	16
SAND	16	22
CLAY	22	87
SAND	83	94
CLAY	94	121
SAND & GRAVEL	121	162

CARRIERE, MS.
(mailing address)

WELL LOCATION:
sec. 11 T 4 N R 17 E
S W
5 miles NW, MEHIEL
(distance) (direction) (nearest town)

WELL PURPOSE: IRRIGATION
(home, irrigation, municipal, industrial)

- WELL COMPLETION DATA:
- (1) diameter (inches) 4
 - (2) total depth (feet) 162
 - (3) static water level (feet) 89 below top of ground.
 - (4) casing PVC, 162,
(material) (depth)
if telescope see back.
(size)
 - (5) screen 20, 142
(length) (depth to top)
4", PVC
(size) (material)
 - (6) pump 3, 42
(HP) (yield gpm)
ELEC.
(type power)
 - (7) electric log (yes or no)

(organization running log)

(8) how well bottom plugged sand shark


RECEIVED
JUN 25 1985

DRILLERS REMARKS:

Department of Natural Resources
Bureau of Land & Water Resources

If well telescopes please sketch and show depths.

GROUND LEVEL

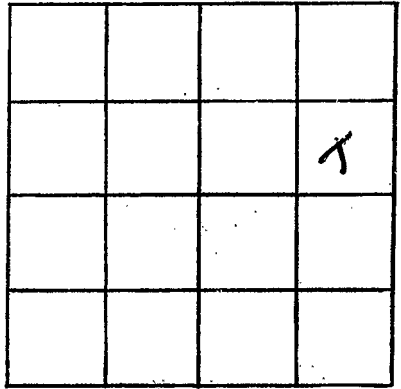

SECTION 11

Please indicate well location X.

ADDITIONAL INFORMATION

If more than one screen, show locations of each on sketch.