

MISSISSIPPI DEPARTMENT OF NATURAL RESOURCES

Bureau of Land and Water Resources

Southport Mall

P.O. Box 10631

Jackson, Mississippi 39209

WATER WELL DRILLERS LOG

CODED

PEARL RIVER  
P82  
8-21-85

BUD PENTON & SONS Pearl River

8/21 1985  
date well completed

field name Well Service county well located

LANDOWNER: R G Schirmer

description of formations encountered

from to

R-T-3 carriers

* Red shale	0	60
Blue shale	60	180
Blue sand	180	220
Blue shale	220	400
Grif sand	400	471

M.S. (mailing address)

WELL LOCATION:

sec. 18 T. 4 N R. 17 E  
8 miles NW of Carriere  
(distance) (direction) (nearest town)

WELL PURPOSE: home  
(home, irrigation, municipal, industrial)


WELL COMPLETION DATA:

- (1) diameter (inches) 4
- (2) total depth (feet) 471
- (3) static water level (feet) 70 below top of ground.
- (4) casing PVC, 471, (material), (depth)  
4x2 if telescope see back. (size)
- (5) screen 10, 461 (length), (depth to top)  
1/2, PVC (size), (material)
- (6) pump 1, 1350 (HP), (yield gpm)  
Elect (type power)
- (7) electric log NO (yes or no)

(organization running log)

(8) how well bottom plugged

DRILLERS REMARKS:

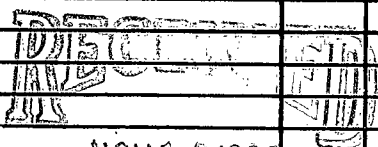


NOV 1 0 1985

Department of Natural Resources  
Bureau of Land & Water Resources

If well telescopes please sketch and show depths.

GROUND LEVEL

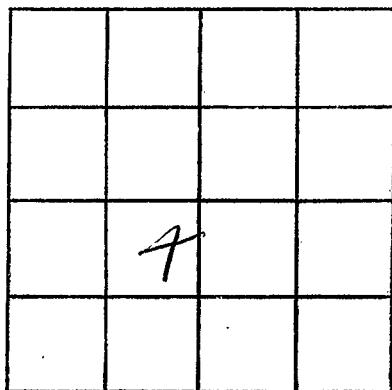

SECTION \_\_\_\_\_

Please indicate well location X.

ADDITIONAL INFORMATION

If more than one screen,  
show locations of each on sketch.