

Pearl River
P 83

MISSISSIPPI DEPARTMENT OF NATURAL RESOURCES
 Bureau of Land and Water Resources
 Southport Mall
 P.O. Box 10631
 Jackson, Mississippi 39209
WATER WELL DRILLERS LOG

CODED

4/22 19 87 Bud Penton Pearl River
 date well completed firm name county well located
Water Well

LANDOWNER: Lee Glas
R.T. 1 Box 293A
Carriere Miss 39426
 (mailing address)

WELL LOCATION:
 sec 34 T 4 N R 17 E
6 miles west of Carriere
 (distance) (direction) (nearest town)

WELL PURPOSE: home
 (home, irrigation, municipal, industrial)

- WELL COMPLETION DATA:
- (1) diameter (inches) 2
 - (2) total depth (feet) 990
 - (3) static water level (feet) 8 below/above top of ground.
 - (4) casing PVC, 990,
 (material) (depth)
 (size) if telescope see back.
 - (5) screen 15, 975
 (length) (depth to top)
12, PVC
 (size) (material)
 - (6) pump no
 (HP) (yield gpm)
 (type power)
 - (7) electric log no
 (yes or no)
 (organization running log)
 - (8) how well bottom plugged shrub

description of formations encountered	from to	
<u>Red shale</u>	<u>0</u>	<u>20</u>
<u>Red sand</u>	<u>20</u>	<u>35</u>
<u>Blue shale</u>	<u>35</u>	<u>210</u>
<u>Blue sand</u>	<u>210</u>	<u>275</u>
<u>Blue shale</u>	<u>275</u>	<u>930</u>
<u>Gray sand</u>	<u>930</u>	<u>990</u>

CODED

RECEIVED


JUN 16 1987

Department of Natural Resources
 Bureau of Land & Water Resources

DRILLERS REMARKS:

If well telescopes please sketch and show depths.

GROUND LEVEL

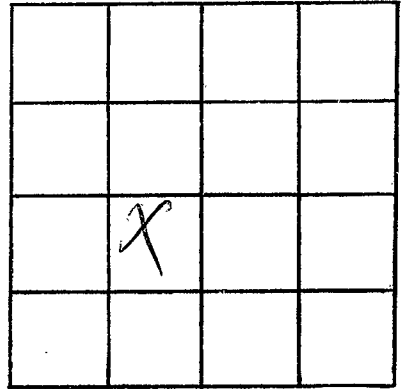

SECTION _____

Please indicate well location X.

ADDITIONAL INFORMATION

If more than one screen,
show locations of each on sketch.