

MISSISSIPPI DEPARTMENT OF ENVIRONMENTAL QUALITY
POUNCEY WATER WELLS
 Office of Land and Water Resources

Adron A. Pouncey
 10200 Possum Fork
 Picayune, MS 39466

P. O. Box 10631
 Jackson, MS 39289-0631
WATER WELL DRILLERS LOG

COUNTY WELL LOCATED
Pearl River
 WELL NUMBER
P-88 CODED
 DATE WELL COMPLETED
4/8/02

PERMIT NUMBER
 NAME OF DRILLING FIRM

NAME & MAILING ADDRESS OF LANDOWNER
*Waste Management Houston
 Central Land Fill Hwy 11*

Latitude:
 Longitude:

WELL LOCATION. SEC TOWNSHIP RANGE
9 4 N 17 E

DISTANCE DIRECTION NEAREST TOWN
1 1/2 Miles S/E of Millard

OTHER LANDMARK
one strip

WELL PURPOSE: Home, Irrigation, Municipal, Industrial, Fish Pond, etc.
Bathrooms - office - road water

WELL DATA
 Well Depth Casing Diameter (In.) Casing Length (Ft.)
538 4 1/2 518
 Type of Casing Hole Depth Depth to Static Water Level
PVC 538 108

TYPE OF COMPLETION: (Circle One or More):
 Gravel Packed, Underreamed, Telescoped,
~~Natural Development~~, Open Hole, Other
 (Describe) *7 air*

WELL GROUTED TO A DEPTH OF *20/30* FEET
 Type Grout (circle one): Cement, Bentonite, or Mix

SCREEN DATA
 Diameter - Inches Length - Feet Slot Size - Inches
2 70 10/10 - 10/12
 Screen Type Depth to Bottom - Feet
PVC wrap 538

PUMP DATA
 PUMP TYPE (Circle One):
 Submersible, Turbine, Jet, Flowing Well,
 Other (Describe) *5 from old well -*
 POWER TYPE (Circle One):
 Electric, Tractor, Diesel, Gasoline, Butane,
 Other (Describe) *H/P 5*

| DESCRIPTION OF FORMATIONS ENCOUNTERED | FROM | TO |
|---------------------------------------|------------|------------|
| <i>Top surface</i> | <i>0</i> | <i>12</i> |
| <i>Clay</i> | <i>12</i> | <i>86</i> |
| <i>Silt. Rock</i> | <i>86</i> | <i>180</i> |
| <i>Blue clay</i> | <i>180</i> | <i>280</i> |
| <i>Silt. Shale with Mk -</i> | <i>285</i> | <i>410</i> |
| <i>AD. Shale</i> | <i>410</i> | <i>470</i> |
| <i>Fine to Better on Bottom</i> | <i>470</i> | <i>538</i> |

RECEIVED
FEB 06 2003
BY: OLWR
 Top of Lap Pipe or Reduction in Casing
240 FEET IF TELESCOPED OR MORE THAN ONE SCREEN: USE BACK PAGE

I certify that the well was drilled, constructed and completed in accordance with all applicable requirements of the Mississippi Department of Environmental Quality and/or the Mississippi Department of Health regulations and state laws.

Signature of Licensed Driller and License No. *Reynolds* *5/1/02*
New *2/1/03*
for Date


If well telescopes please sketch and show depths.

GROUND LEVEL

2' 10"

1' 7"

30'

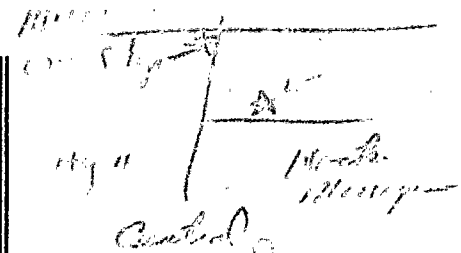

| | | | |
|-----|-----|-----|-----|
| 10' | 10' | 10' | 10' |
| | | | * |
| | | | |
| | | | |

SECTION 7

Please indicate well location X.

| | | |
|---------------------|---------------|---------------|
| Pump Capacity (GPM) | No. of Stages | Setting Depth |
| | | 140 FT. |

PUMP TEST

Well yielded 50-55 GPM with a drawdown of _____ ft. after 2 days hours of pumping

LOG DATA

TYPE OF LOG RUN (Circle One): No Log Run, Electric, Gamma Ray, Density, Sonic, Neutron, Other (Describe) _____

Name of Organization Running Log

GEOLOGIC DATA (Office Use Only)

| Surface Elev. | Geologic Unit | Unit Thickness | Depth to Top |
|---------------|---------------|----------------|--------------|
| | | | |
| Subs. SWL | Date | Analysis | Aquifer Test |

Driller's Remarks

11/2\"/>

If more than one screen, show location of each on sketch.