

WATER WELL DRILLERS LOG

10-18-63

Date: 10-18, 1963, Driller: Sutter Well Works County Pearl River
(Name)


(1) Owner of Land: Mrs. Dewey Howard
(Name)
McNeill Miss.
(Address)
(2) Location: SE 1/4, NW 1/4, Sec. 25 T45R12W
1 miles W, of McNeill
(distance) (direction) (Nearest Town)
(3) Topography: hilly
(Hilly) (Flat) (Level)
(4) Purpose of Well: domestic
(Domestic Irrigation
Municipal, Industrial, Other)

Description & Color of Materials Sand, Clay, Red Clay, Shell, etc.	Thick- ness Feet	Depth Feet
Clay	18	18
Sand	37	55
Clay	35	90
Sand	42	132

Information upon completion of well:

(1) Diameter 2 inches.
(2) Total Depth 132 feet.
(3) Water Level 41 feet below top of ground.
(4) Cased to all, Size 2"
(5) Screen: Size 2", Length 5'
(6) Were any formations sealed against pollution?
yes, no.

If YES depth of formation _____
Why _____
Drillers Remarks: _____

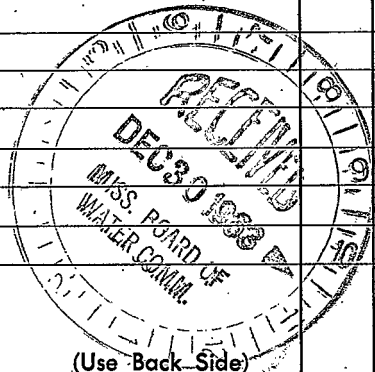

Well No.

1910

1911

1912

1913

1914

1915

1916

1917

1918

1919