

P 2001
11-12-63

WATER WELL DRILLERS LOG



Date: 11-12, 19 63, Driller: Sutter Well Works County Pearl River
(Name)

| (1) Owner of Land: | Description & Color of Materials Sand, Clay, Red Clay, Shell, etc. | Thick- ness Feet | Depth Feet |
|--|---|-------------------------------|--------------------------------|
| La Row Investment Co. (Name) Percyune, Miss. (Address) | Clay | 18 | 18 |
| NW 1/4, SE 1/4, Sec. 20 T45R19W (Location) 10 miles W of Mc Nair, (distance) (direction) (Nearest Town) | red sand Clay sand Clay sand | 37 139 103 29 304 | 55 194 297 326 630 |
| (3) Topography: Hilly (Hilly) (Flat) (Level) | Clay sand | 42 64 | 672 736 |
| (4) Purpose of Well: Domestic (Domestic Irrigation Municipal, Industrial, Other) | | | |

Information upon completion of well:

- (1) Diameter 4 inches.
- (2) Total Depth 736 feet.
- (3) Water Level 52 feet below top of ground.
- (4) Cased to all, Size 4"
- (5) Screen: Size 4", Length 20'
- (6) Were any formations sealed against pollution?
yes, no.

If YES depth of formation _____
Why _____
Drillers Remarks: _____

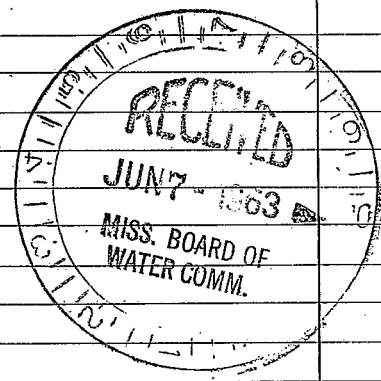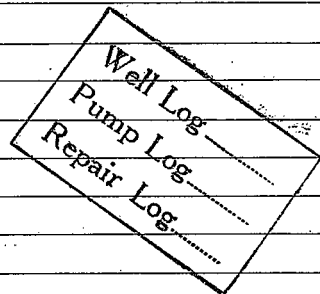

(Use Back Side)

Well No.

