

Pearl River
 P 2004
 5-67

MISSISSIPPI
 BOARD OF WATER COMMISSIONERS
 416 North State Street
 Jackson, Mississippi 39201

WATER WELL DRILLERS LOG
 NEIL LOMPKNIN WELL
 1967 DRILLING SERVICE

PEARL RIVER
 county well located

5-6
 date well completed

firm name

LANDOWNER: G. V. EVANS
 CARRIERE, MISS.
 (mailing address)


description of formations encountered	from	to
Surface Clay	0	10
Sands	10	77

WELL LOCATION:
 sec. 36 T. 45 S. R. 17 W.
 1 1/2 miles NORTH of CARRIERE
 (distance) (direction) (nearest town)

WELL PURPOSE: HOME
 (home, irrigation, municipal, industrial)


- WELL COMPLETION DATA:
- (1) diameter (inches) 2
 - (2) total depth (feet) 77
 - (3) static water level (feet) 40 below top of ground.
 - (4) casing Plastic, 71'
 (material) (depth)
2" if telescope see back.
 (size)
 - (5) screen 6', 71'
 (length) (depth to top)
2", plastic
 (size) (material)
 - (6) pump 1/2 Jet, 400 gpm/hr
 (HP) (yield gpm)
electric
 (type power)
 - (7) electric log no
 (yes or no)
no
 (organization running log)
 - (8) how well bottom plugged back
pressure valve

DRILLERS REMARKS:

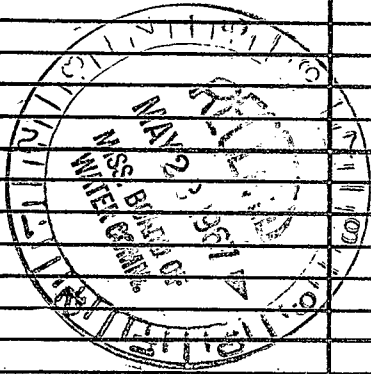

If well telescopes please sketch and show depths.

GROUND LEVEL

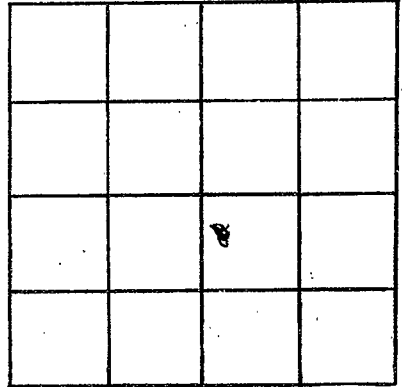

SECTION 36

Please indicate well location X.

ADDITIONAL INFORMATION

If more than one screen,
show locations of each on sketch.