

Pearl River
 P 2005
 11-67

MISSISSIPPI
 BOARD OF WATER COMMISSIONERS
 416 North State Street
 Jackson, Mississippi 39201

WATER WELL DRILLERS LOG

11-11 date well completed 1967 Penlon Well Serv firm name Pearl River county well located

LANDOWNER: H. R. Penlon
 New No Box

Rt. 1

description of formations encountered

from to

Carriere MISS
 (mailing address)

Red Clay

0 22

SAND

22 50

Blue Clay

50 187

Grey Sand

187 216

WELL LOCATION:

sec. 28 T 4 S R. 17 W
0 miles 0 of Mill Creek
 (distance) (direction) (nearest town)

WELL PURPOSE: Home
 (home, irrigation, municipal, industrial)

WELL COMPLETION DATA:

(1) diameter (inches) 4 1/2 Drilled

(2) total depth (feet) 216

(3) static water level (feet) 83 below top of ground.

(4) casing Galv. Steel 2 1/2"
 (material) (depth)

2" If telescope see back.
 (size)

(5) screen 5', 2 1/2"
 (length) (depth to top)

012 2", S. Steel
 (size) (material)

(6) pump 1 5
 (HP) (yield gpm)


Elec
 (type power)

(7) electric log No
 (yes or no)

(organization running log)

(8) how well bottom plugged B.W. Valve

DRILLERS REMARKS:

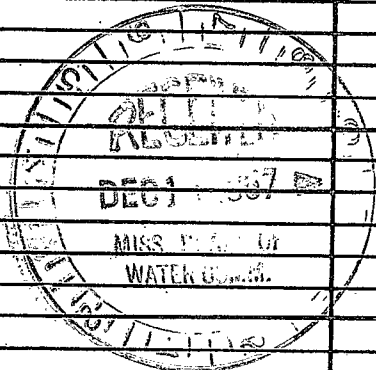

If well telescopes please sketch and show depths.

GROUND LEVEL

			X

SECTION 28

Please indicate well location X.

ADDITIONAL INFORMATION

If more than one screen, show locations of each on sketch.